


G-8183

54621

T.13S. R.30E.W.M.

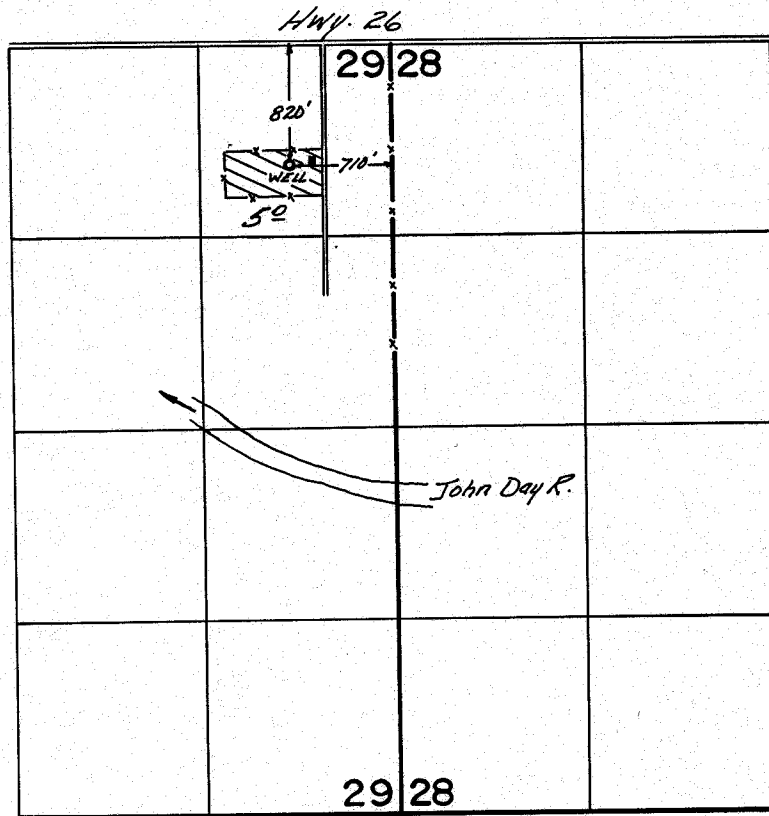

FINAL PROOF SURVEY
UNDER

Application No. G-8804 Permit No. G-8183.....
IN NAME OF

.....DONALD CATES.....

Surveyed July...18.. 1979, by S.C.BROWN.....

PTS-1979-B-622