


T. 34S., R. 1W., W.M.

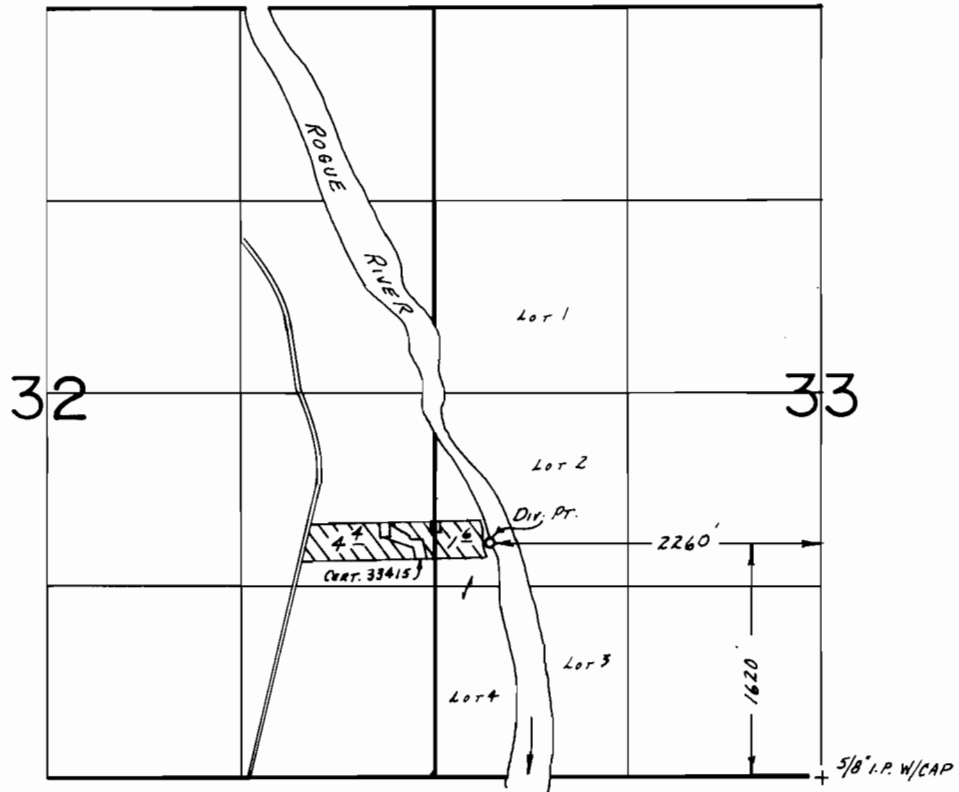

SCALE: 1"=1320'

FINAL PROOF SURVEY
UNDER

Application No. 54605. Permit No. 40974.....
IN NAME OF

.....ELWOOD M. LEE.....

Surveyed Nov. 5..... 19.85, by B.S. JAMES.....