


T.34S., R.1W., W.M.

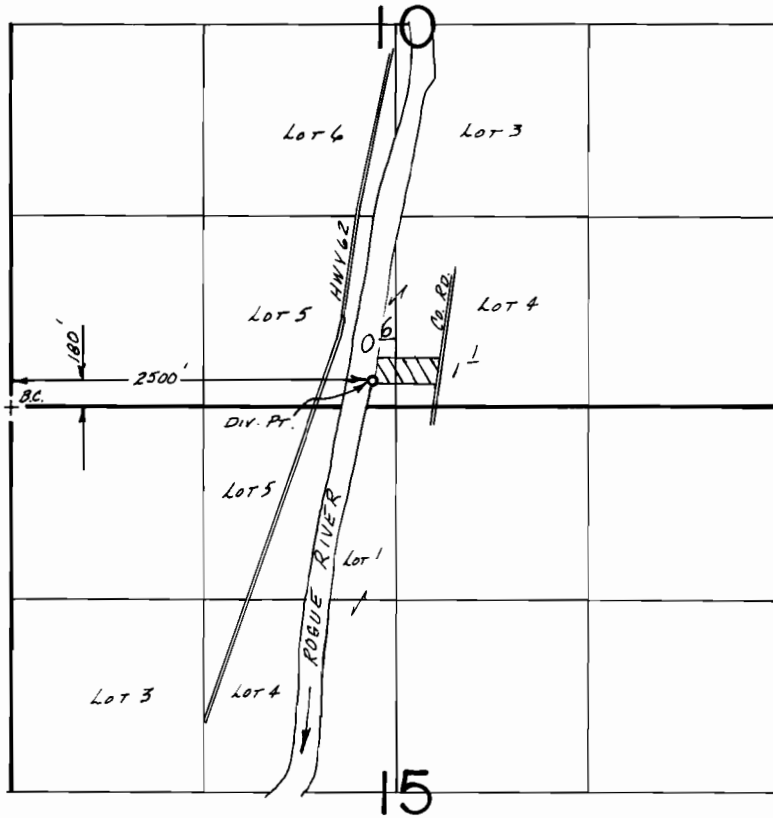

SCALE: 1" = 1320'

**FINAL PROOF SURVEY**  
UNDER

Application No. 59766.. Permit No. 44984.....  
IN NAME OF

MR. & MRS. HARLAN McELROY

Surveyed Nov. 6..... 19.85., by B.S. JAMES.....