


T.15S.,R.4&5W.,W.M.

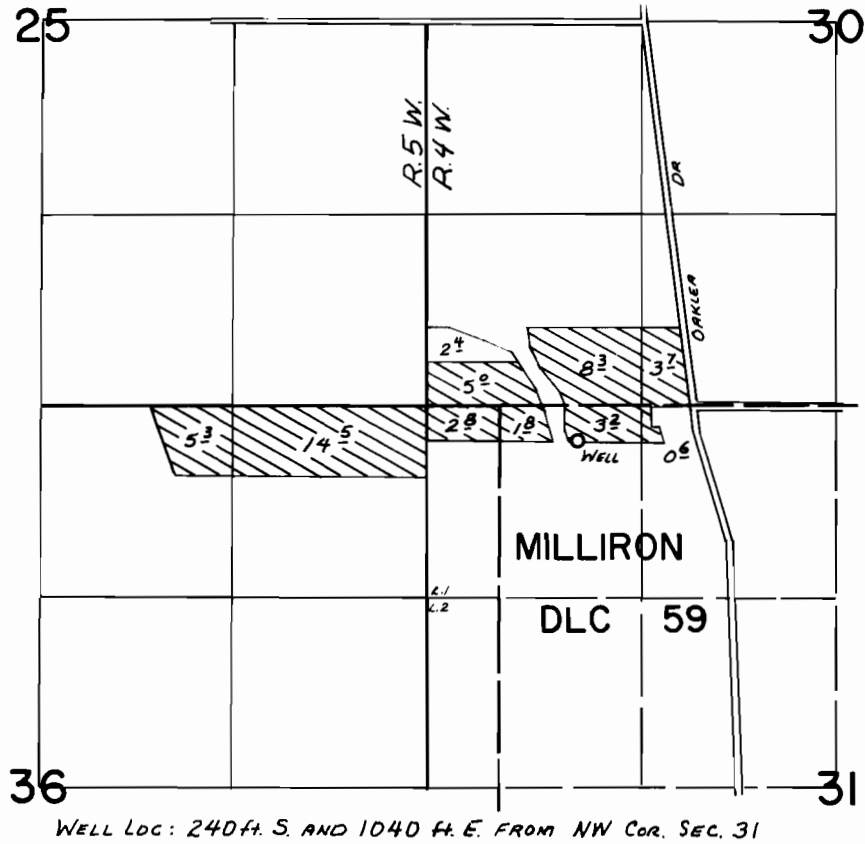

FINAL PROOF SURVEY
UNDER

Application No. G-6733. Permit No. G-6263.....
IN NAME OF

GUY M. GILMORE

Surveyed Aug. 4, 1982, by L.M. TOLL.....