


T.IOS.,R.IE.,W.M.

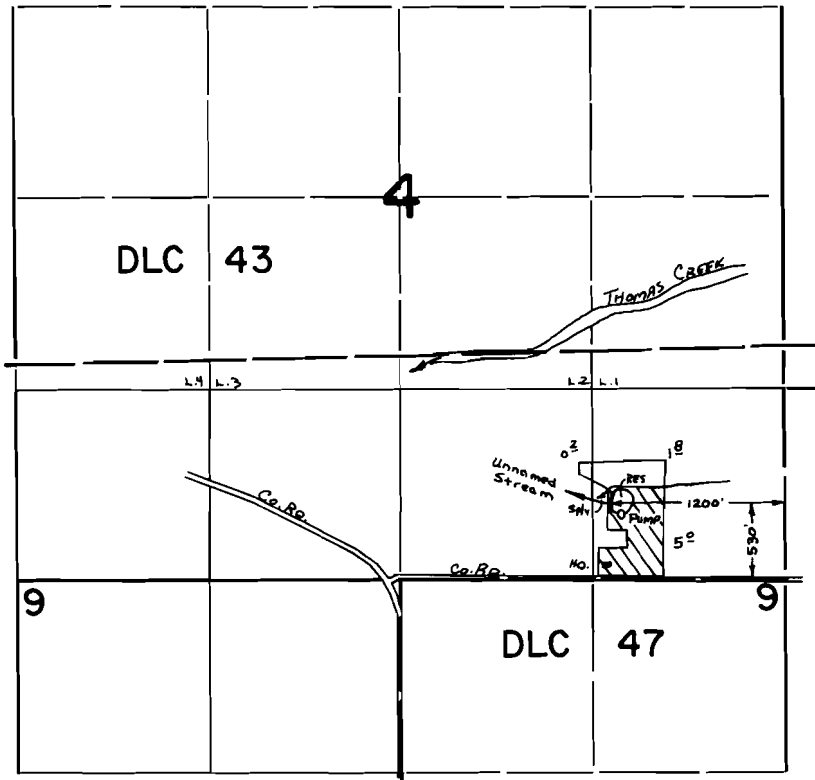

FINAL PROOF SURVEY UNDER

Application No. R-58689 58690 Permit No. R-8236 45558

IN NAME OF

JAMES L. & LOUELLA C. MONROE

Surveyed June 11, 1982, by L.M. TOLL