


T. 12S., R. 2W., W.M.

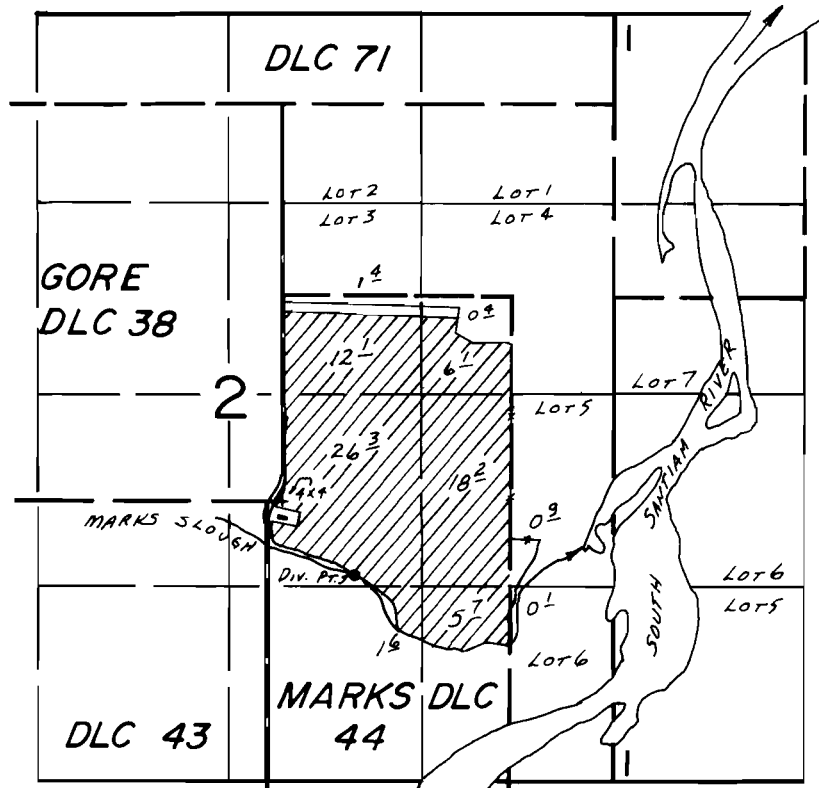

DIV. PT. LOC: 500' S. & 500' E. FROM SE COR. GORE DLC 38.

FINAL PROOF SURVEY
UNDER

Application No. 58727... Permit No. 44200.....
IN NAME OF

.....LYLE CALDWELL.....

Surveyed MAY 26, 1982, by L.M. TOLL.....