


T. 10S., R. 1W., W.M.

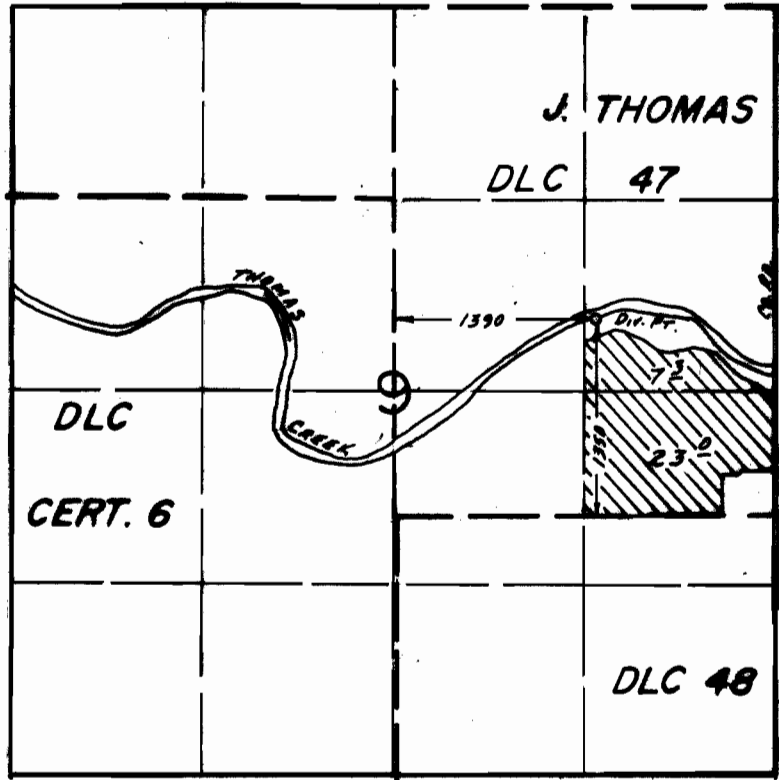

SCALE: 1"=1320'

FINAL PROOF SURVEY
UNDER

Application No. 67693.. Permit No. 4826].....
IN NAME OF

.....MORRIS W. IRWIN.....

Surveyed Sept. 4.... 19.85, by T.M. WARREN.....