


T. 9S., R. 1W., W. M.

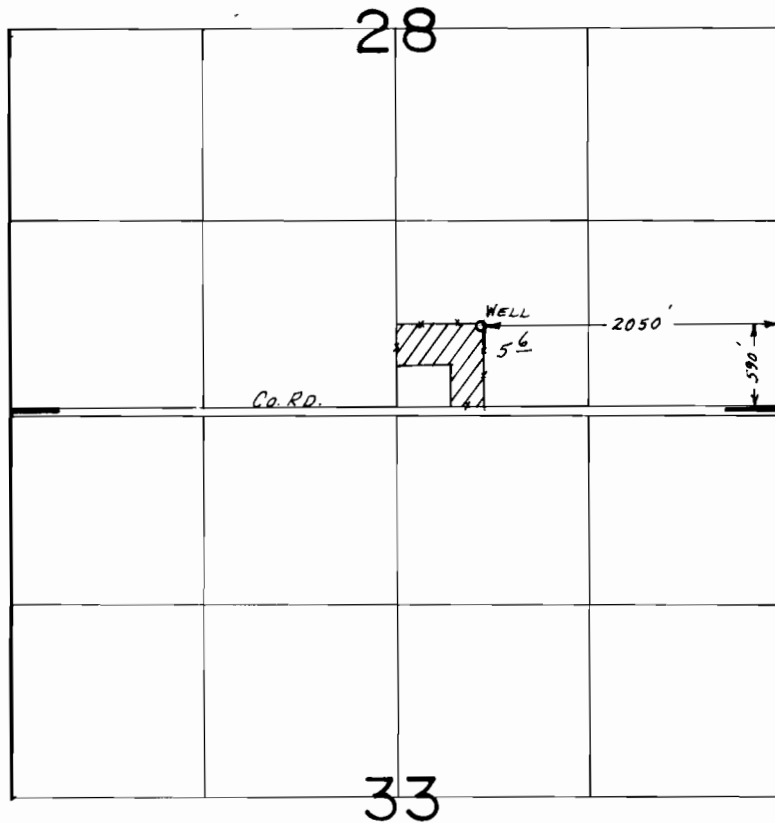

SCALE: 1" = 1320'

**FINAL PROOF SURVEY**  
UNDER

Application No. G-10157. Permit No. G-9184.....  
IN NAME OF

.....ROBERT DAVID WILSON.....

Surveyed Sept. 4.... 19.85., by J. M. WARREN.....