


T.8&9S., R.3W., W.M.

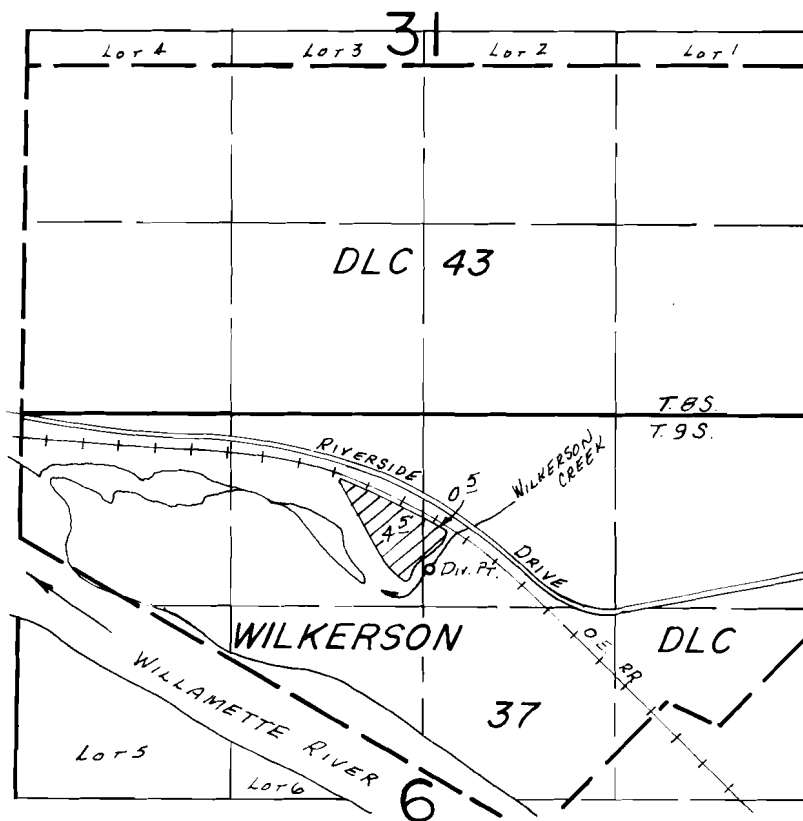

Div. Pt. Loc.: 1050'S. & 40'E. FROM N. 1/4 COR. SEC. 6.

SCALE: 1" = 1320'

FINAL PROOF SURVEY UNDER

Application No. 58499.. Permit No. 44040.....
IN NAME OF

.....SHARON BRAZIEL.....

Surveyed May 2..... 19.85, by P.R. PAGTER.....