


# T.6S. R.1E. W.M.

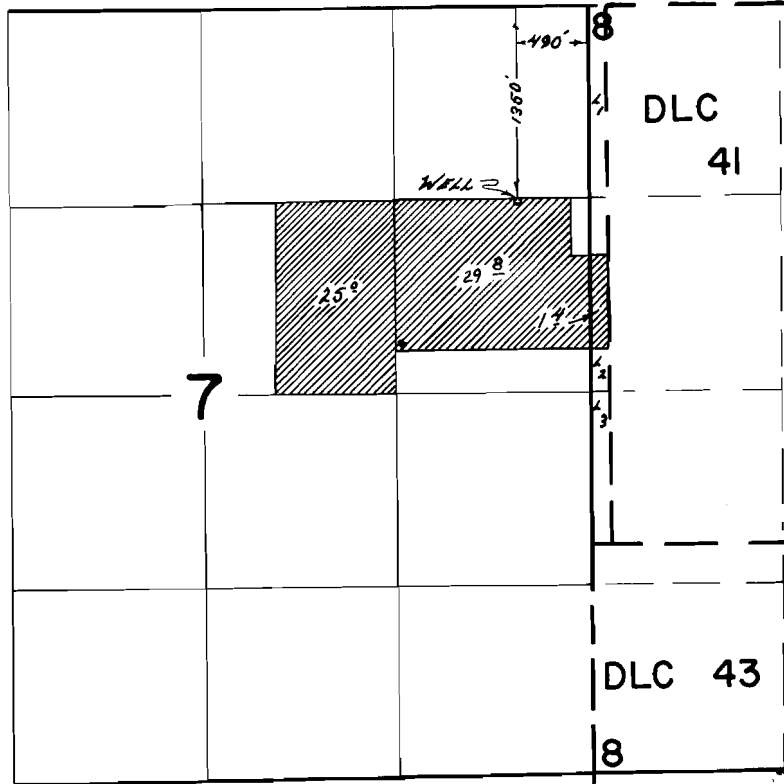

## FINAL PROOF SURVEY UNDER

Application No. G-4436 Permit No. G-4179  
IN NAME OF

*Samson Anfilofieff*

Surveyed JUNE 7 1973, by R.B. MUCKEN