


T.I.N.R.I.W.W.M.

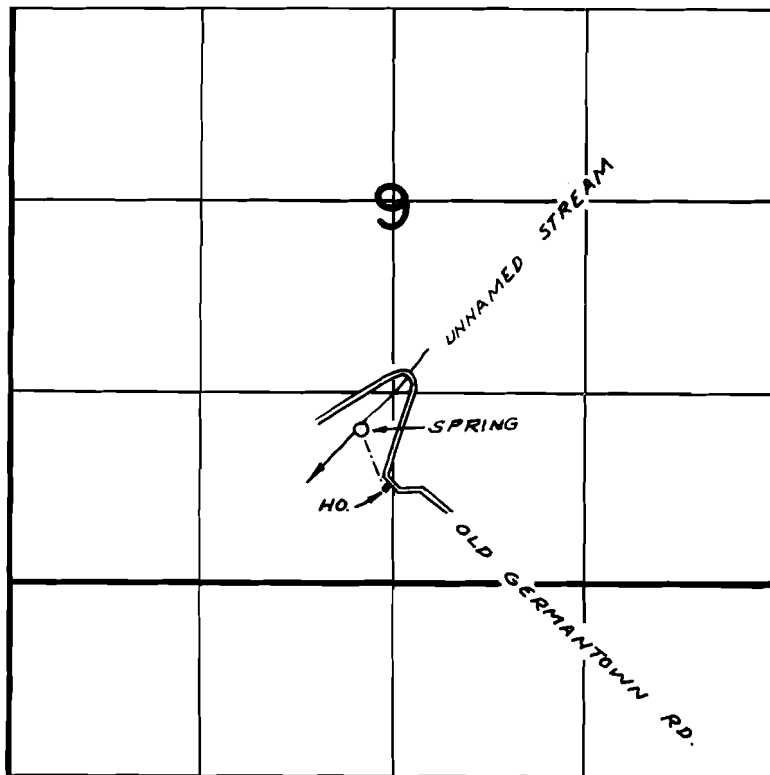

SPRING LOC: 1050' N. & 220' W. FROM $S\frac{1}{4}$ COR. SEC. 9

FINAL PROOF SURVEY UNDER

Application No. 58183 Permit No. 43924
IN NAME OF

JOYCE & PAUL KIRKLAND

Surveyed NOV. 8, 1979, by R.G. MUCKEN