


T.7S., R.24E., W.M.

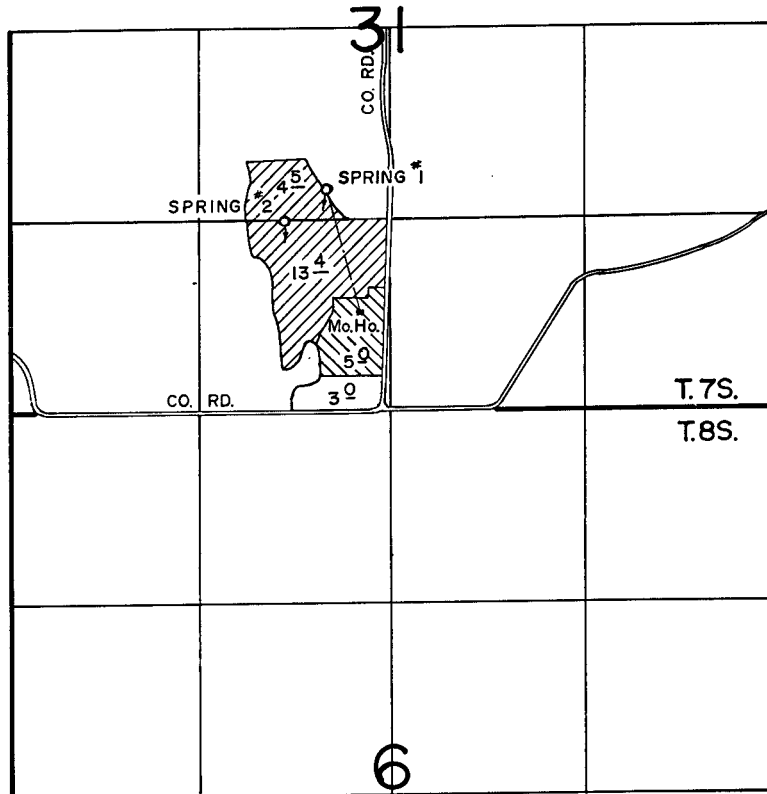

SPRINGS LOC.: No.1; 1520'N. & 430'W., No.2; 1310'N. & 730'W., FROM S.1/4 COR. SEC.31.

FINAL PROOF SURVEY UNDER

 SPRING No.1
 SPRING No.2

Application No. 51016..... Permit No. 38219.....
IN NAME OF

EVELYN MAURATT.....

Surveyed AUG.14..... 19.79., by S.C. BROWN.....