


G-7973
54368

T. 6N., R. 34E., W.M.

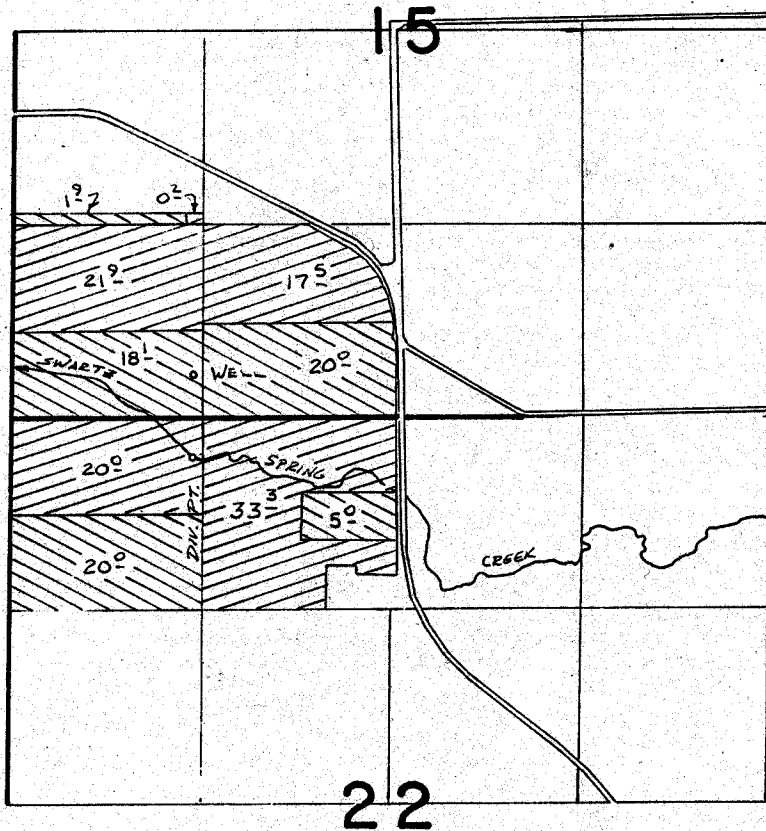

DIV. PT. LOCATED 260' S. & 1250' E FROM NW COR. SEC 22
WELL LOCATED 300' N. & 1250' E FROM SW COR. SEC 15



SUPPLEMENTAL



PRIMARY

FINAL PROOF SURVEY
UNDER

TRANSFER 3843

Application No. **G-8599** Permit No. **G-7973**
IN NAME OF

.....**PHILLIP L HOON**.....

Surveyed ..**2-21**..... **1978**.. by **R. BROWN**.....
3-22 84 V. Church

SCALE 1"=1320'