
T13S. R6W. WM.

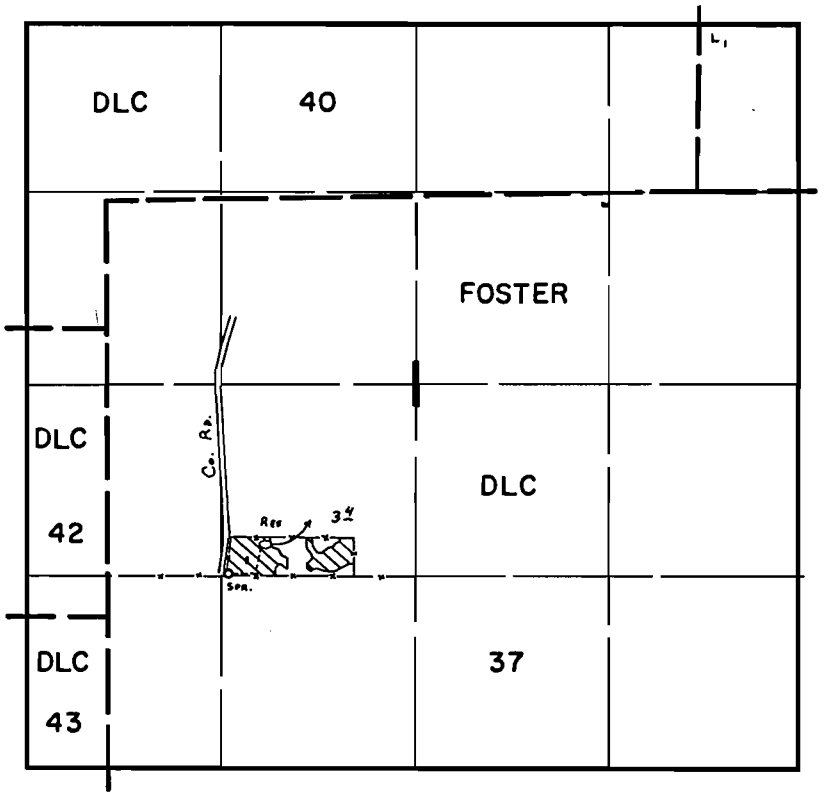

SPRING LOCATED: 20'N. & 40'E. fr. S.W. COR. of N.E.¼ S.W.¼ SEC. 1

FINAL PROOF SURVEY

UNDER

R-56551 R-6659
56552 42011

Application No. 47209 Permit No. 35362

IN NAME OF

MARLIN SCHWANKE

Surveyed Aug. 15 19 79, by C. L. HUGHES

DPJ-9LL-16