


T13S. R6W. WM.

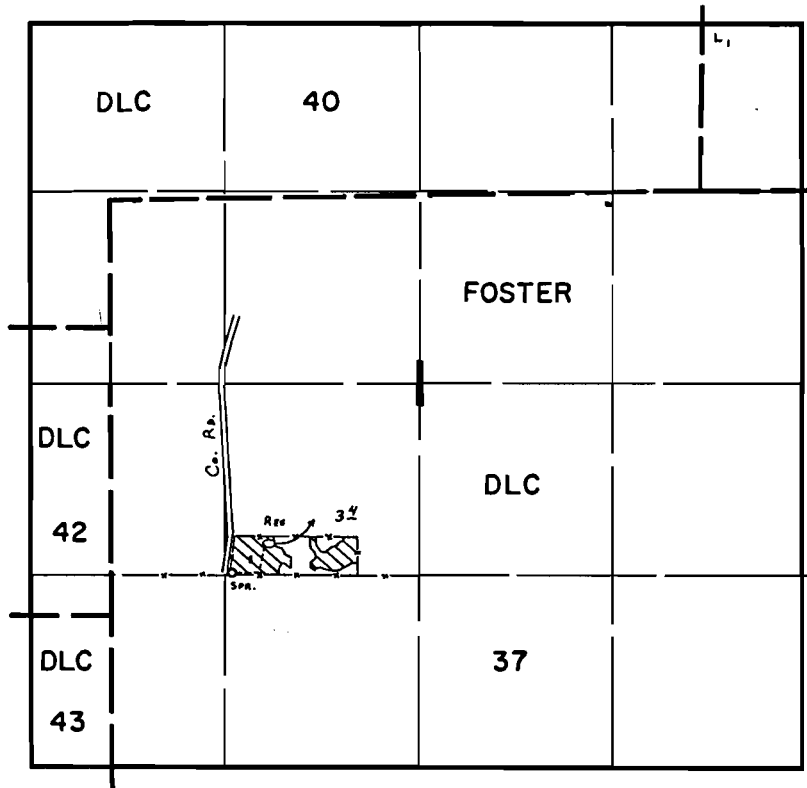

SPRING LOCATED: 20' N. & 40' E. fr. S.W. Cor. of NE 1/4 S.W. 1/4 Sec. 1

FINAL PROOF SURVEY
UNDER

R-56551 R-6659
56552 42011
Application No. 47209. Permit No. 35362.....
IN NAME OF

MARLIN SCHWANKE

Surveyed Aug. 15 1979, by C. L. HUGHES.....