


# T10S. R6W. WM.

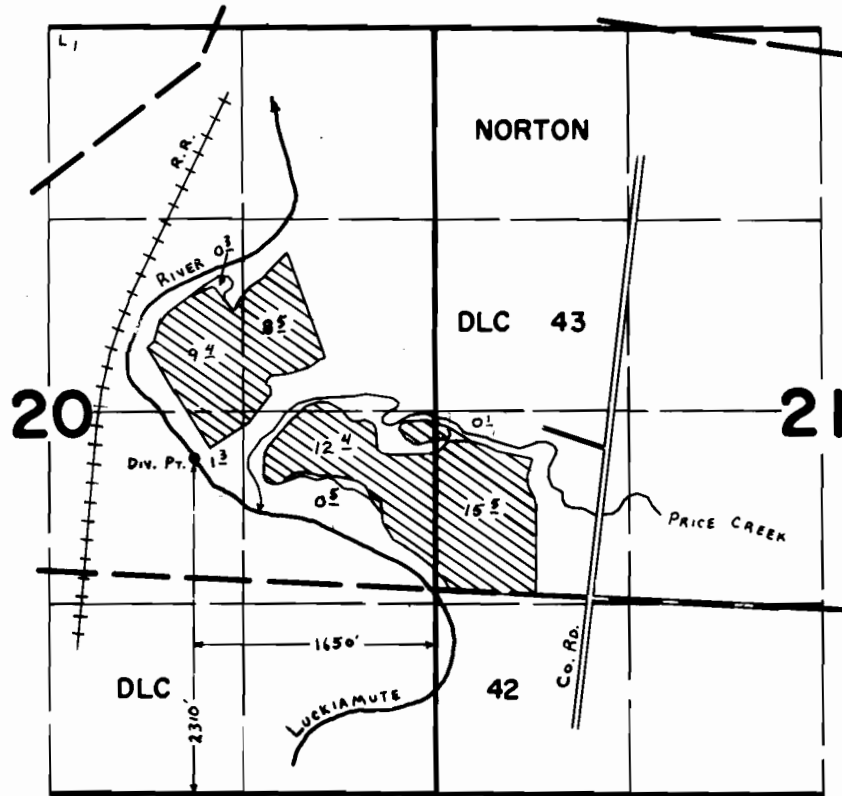

## FINAL PROOF SURVEY UNDER

Application No. 52518 Permit No. 39639  
IN NAME OF

**JACK MAHANA**

Surveyed Aug. 14, 1979, by C. L. HUGHES.