


T13S. R6W. WM.

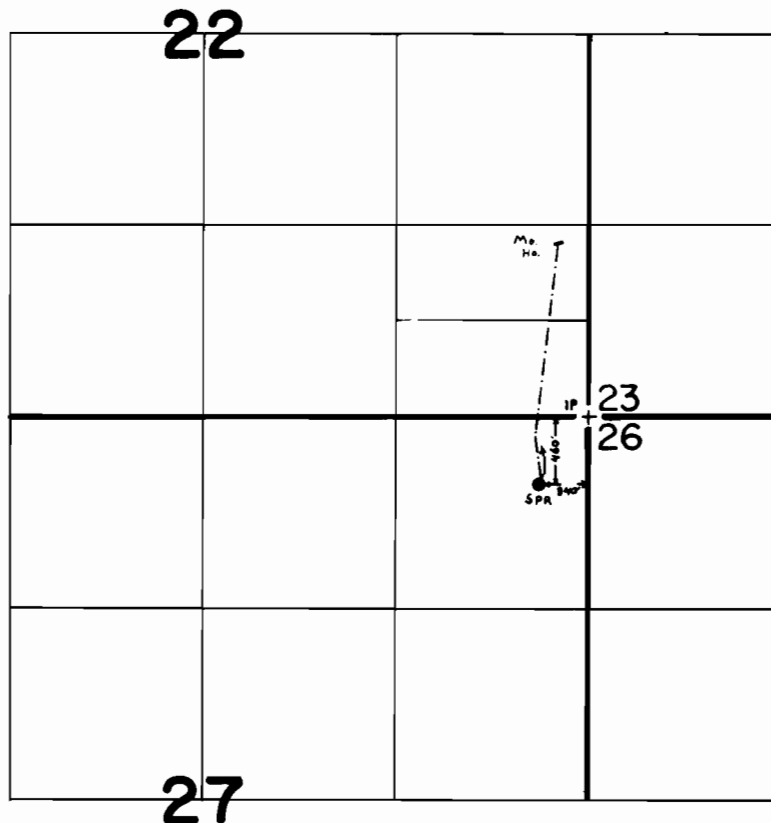

FINAL PROOF SURVEY
UNDER

Application No. 54997..... Permit No. 41592....
IN NAME OF

CHARLES F. & SHARON L. HOLT.....

Surveyed Sept. 4, 1979, by C. L. HUGHES....