


6494
5465

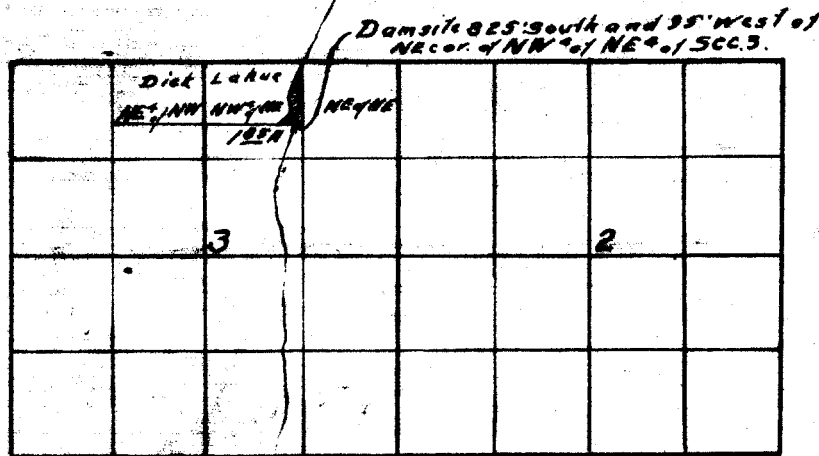

Tp. 35, R. 26 E, W. M.

I, Jos. W. Kirschner, of Heppner, Oregon, do hereby certify that this map was made from notes taken during an actual survey made by me on July 24, 1924, and that it correctly represents the works described in the accompanying application, together with the location of streams and other ditches in the immediate vicinity.

Jos. W. Kirschner,
County Surveyor.

Application No 9725
Permit No 6494

NE cor. of NW 1/4 of NE 1/4

Sec. 3, Tp. 35, R. 26 E, W. M.

Application No 9725
Permit No 6494

NECOR. of NW 1/4 NE 4






