


T. 13S., R. 5W., W. M.

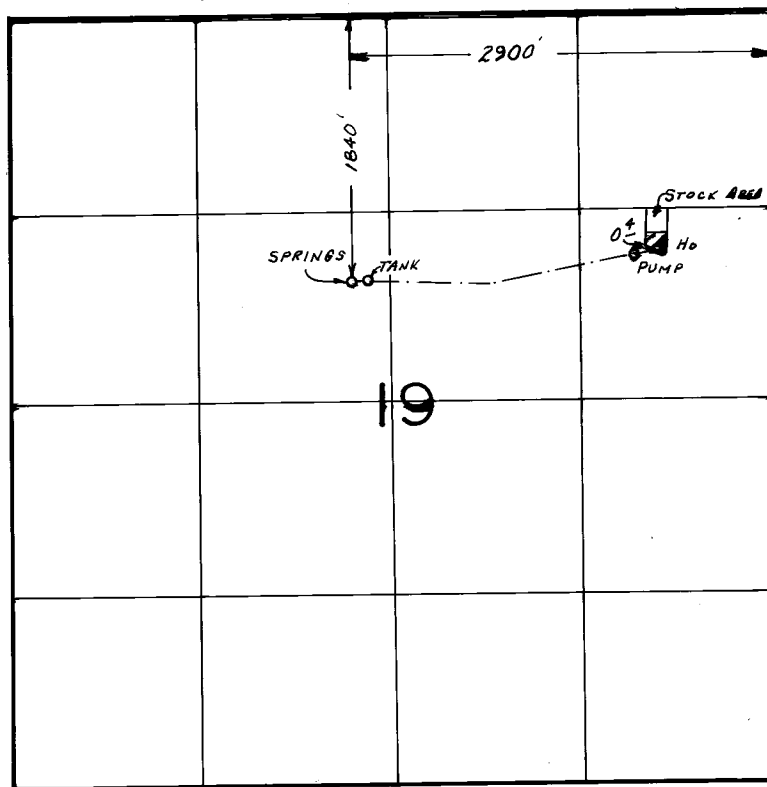

SCALE: 1" = 1320'

FINAL PROOF SURVEY
UNDER

Application No. 59790. Permit No. 44895.....
IN NAME OF

.....HOLIDAY TREE FARMS.....

Surveyed Aug. 3, 1984, by L.M. TOLL.....