


T.3S.,R.1&2E.,W.M.

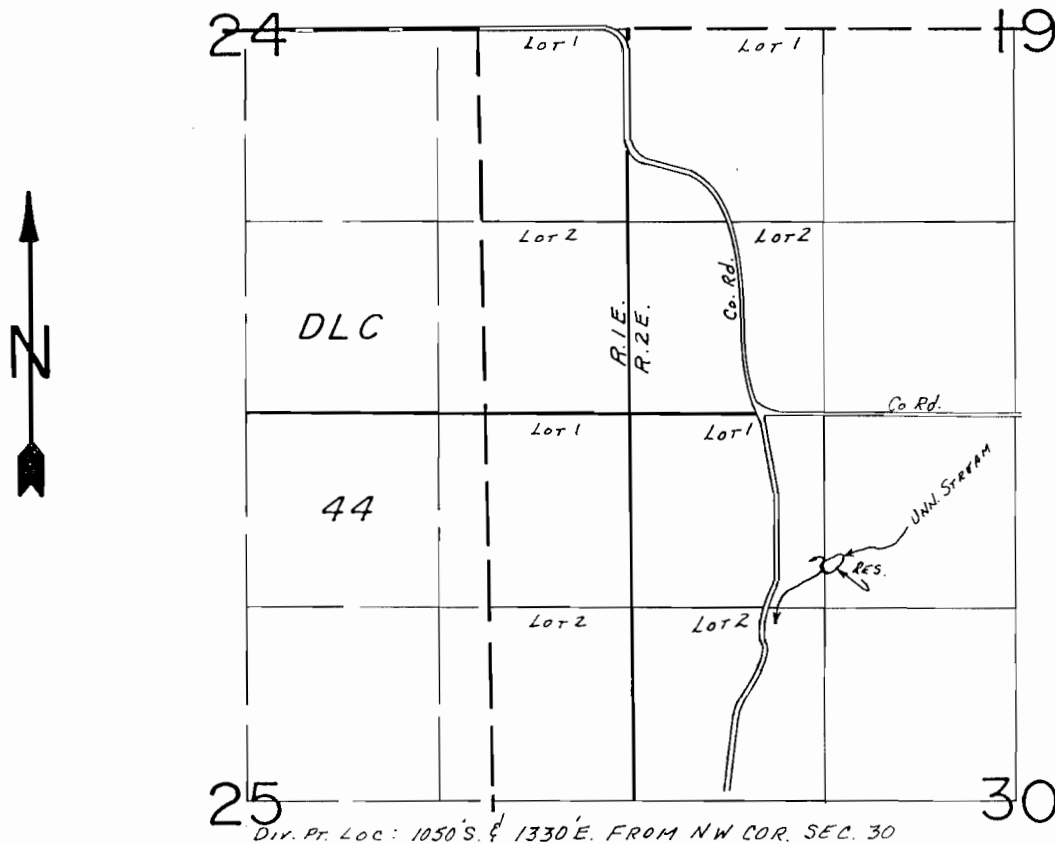

SCALE: 1"=1320'

FINAL PROOF SURVEY
UNDER

R-57490 R-7674
Application No. 57491... Permit No. 43307...
IN NAME OF

.....GEORGE E. KABACY, M.D.

Surveyed AUG. 8.... 1984, by B.W. BISHOP.....