


T.3S.,R.1&2E.,W.M.

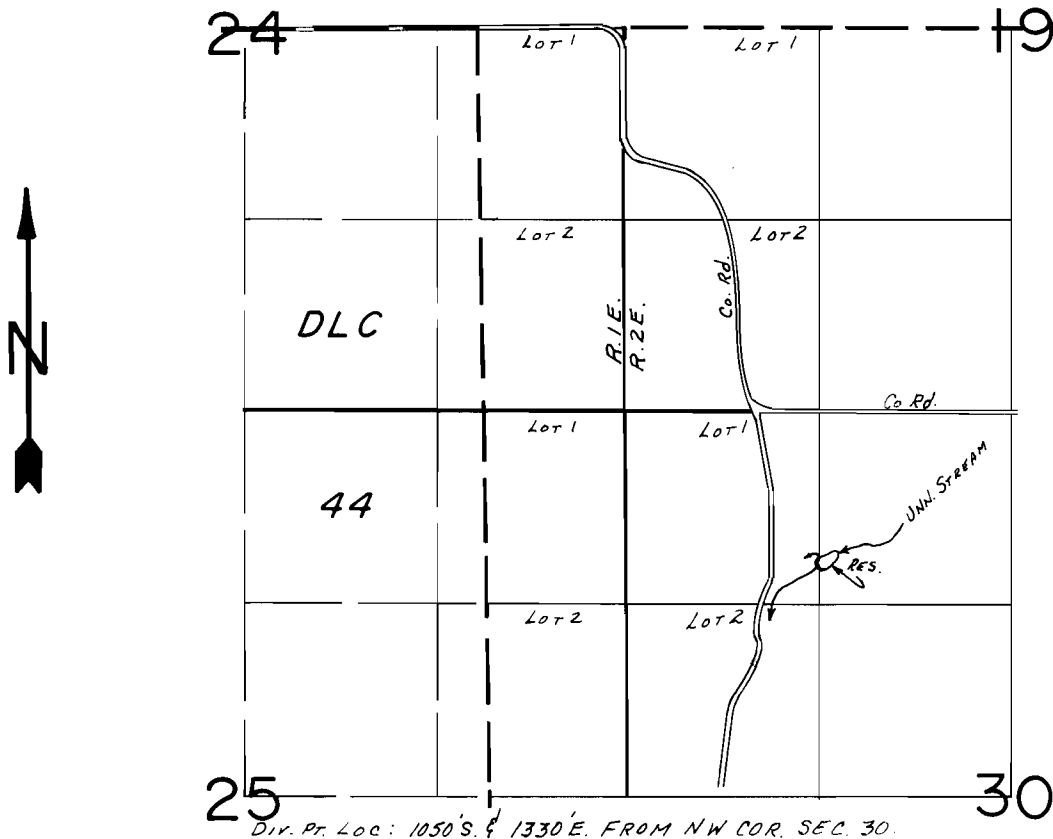

FINAL PROOF SURVEY
UNDER

R-57490 R-7674
Application No. 57491 Permit No. 43307
IN NAME OF

GEORGE E. KABACY, M.D.

Surveyed AUG. 8, 1984, by B.W. BISHOP