


# T.4S. R.1E. W.M.

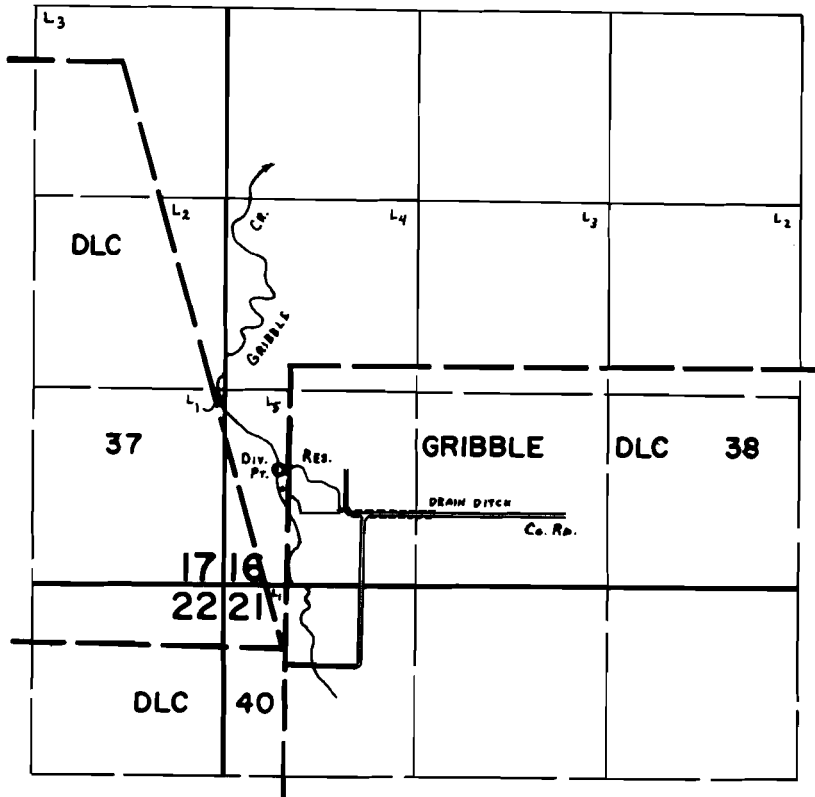

DAM LOC: 660' N. & 450' E. fr. S.W. COR. SEC. 16.  
 DIV. PT. LOC: 790' N. & 370' E. fr. S.W. COR. SEC. 16.

## FINAL PROOF SURVEY UNDER

R-57307                      R-7794  
 Application No. ~~57308~~ Permit No. ~~43921~~.....  
 IN NAME OF

**W. D. GROVES**

Surveyed Oct. 9, 1979, by C. L. HUGHES.....