


# T.4S. R.1E. W.M.

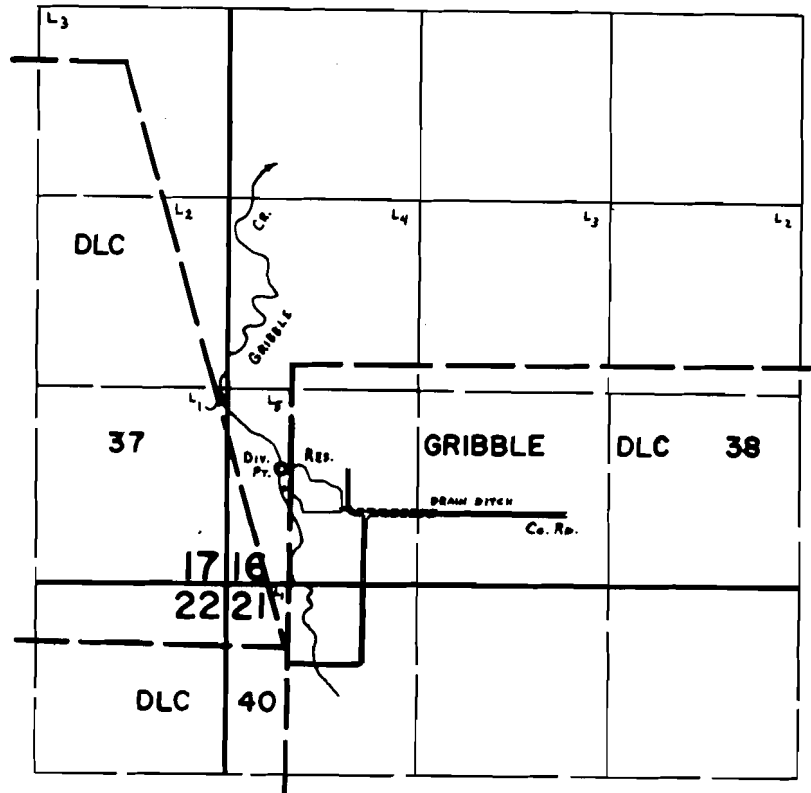

DAM Loc: 660' N. & 450' E. fr. S.W. Cor. Sec. 16.  
 Div. Pt. Loc: 790' N. & 370' E. fr. S.W. Cor. Sec. 16.

## FINAL PROOF SURVEY UNDER

R-57307                      R-7794  
 Application No. 57308.. Permit No. 93921.....  
 IN NAME OF

.....**W. D. GROVES**.....

Surveyed Oct.....9... 19.79., by C.L. HUGHES.....