


T.3S., R.2E., W.M.

SECTION 12

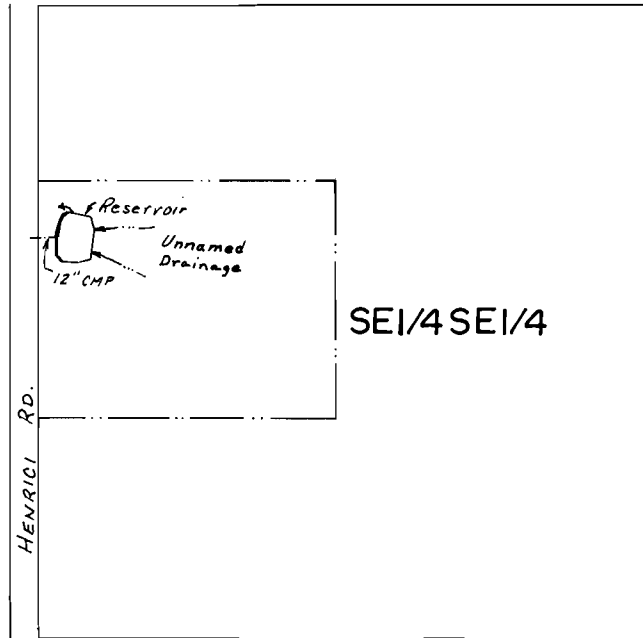

DIV. PT. LOC: 480'S. & 70'E. FROM NW COR SE 1/4 SE 1/4 SEC. 12

SCALE: 1" = 400'

FINAL PROOF SURVEY
UNDER

R-61407 R-8338
Application No. 61408... Permit No. 46337.....
IN NAME OF

..... JOHN B. STANCHFIELD

Surveyed AUG. 9..... 1984, by B.W. BISHOP.....