


T.2&3S.R.2E.W.M

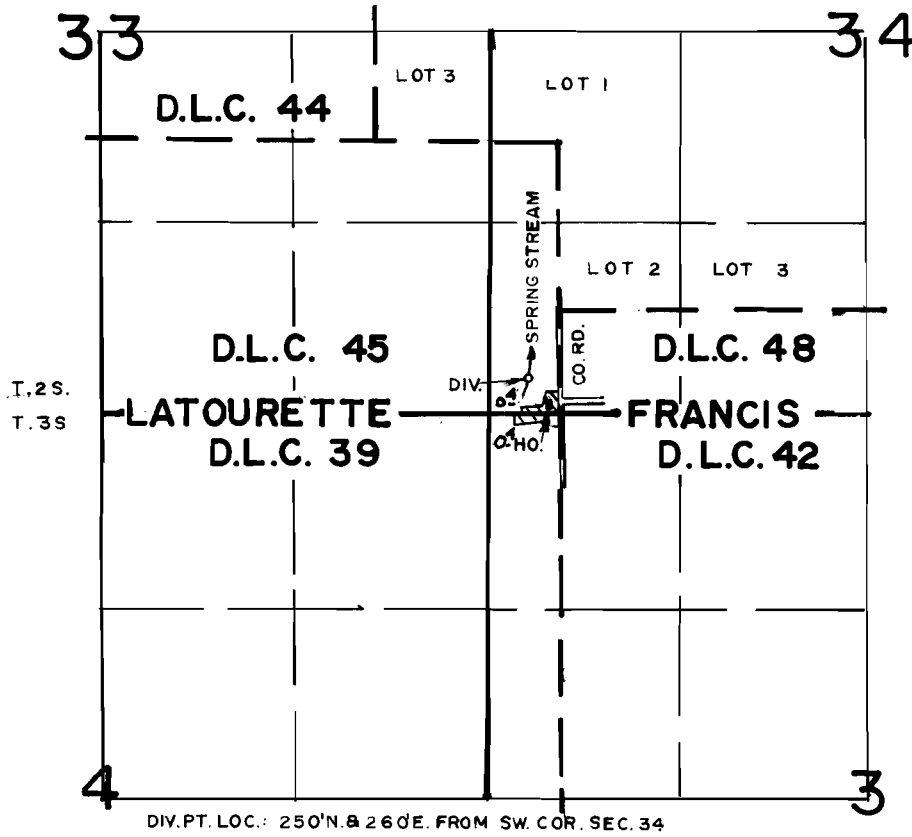

FINAL PROOF SURVEY UNDER

Application No. 50249. Permit No. 37885.....
IN NAME OF

.....WENDELL WILLIAM HEAGLE.....

Surveyed MAR. 14.... 1980., by R.G. MUCKEN.....