


# T.2S.R.2E.W.M.

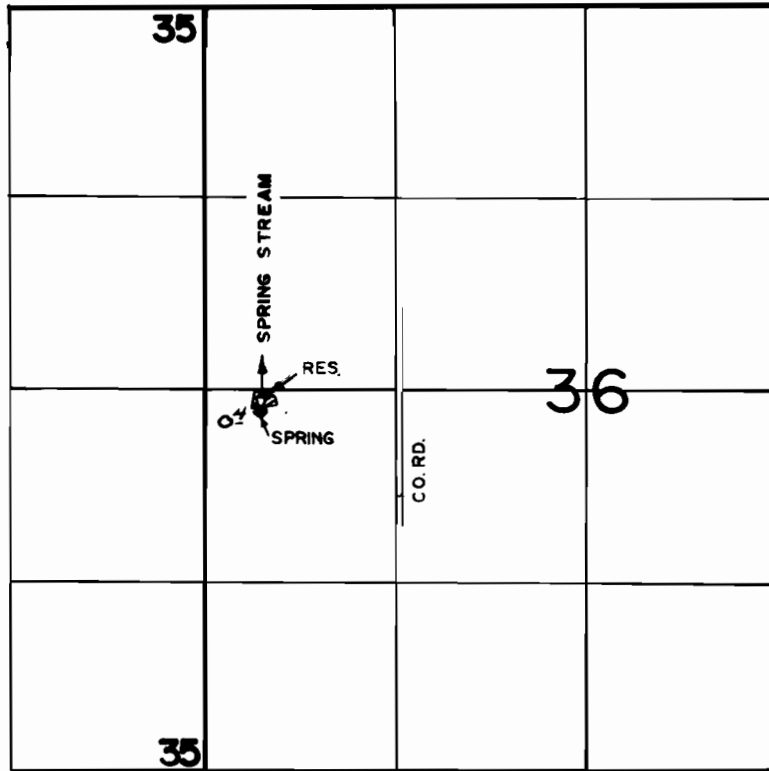

DIV. PT. LOC: 50'S. & 400'E. FROM W. 1/4 COR. SEC. 36

## FINAL PROOF SURVEY UNDER

Application No. 50012... Permit No. 37948.....  
IN NAME OF

.....ERVIN DUNN.....

Surveyed MAR. 14. 1980., by R.G. MUCKEN.....