




T. 3 S., R. 1 & 2 E., W.M.

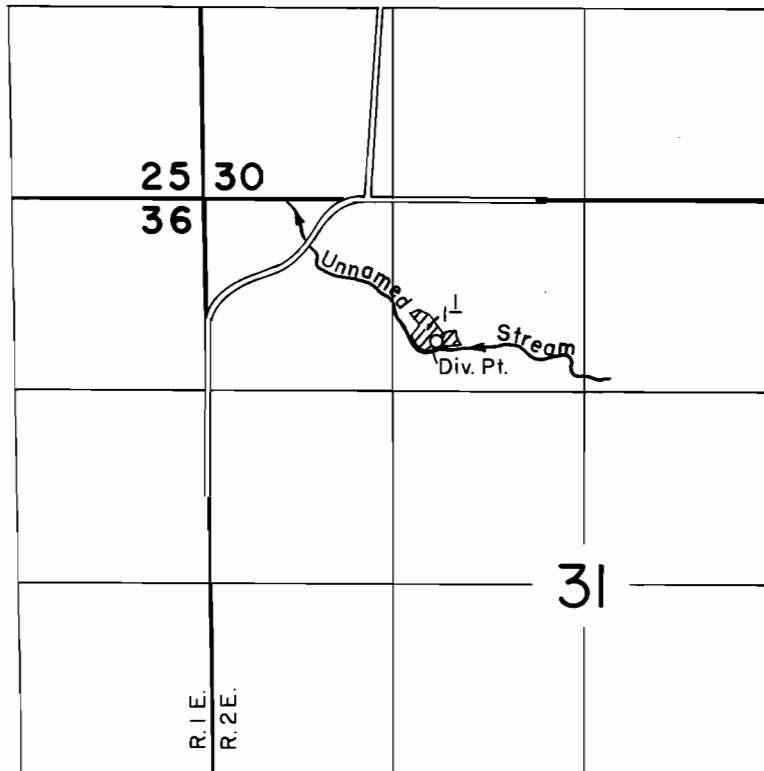

DIV. PT. LOC: 970' S. & 1560' E. FROM THE N.W. CORNER SEC. 31

SCALE: 1" = 1320'

FINAL PROOF SURVEY

UNDER

Application No. 55533.. Permit No. 42194.....
IN NAME OF

.....KENNETH F. WIELAND.....

Surveyed AUG. 23.. 1985.. by ..T.. WARREN.....