


T.6S. R.2E. W.M.

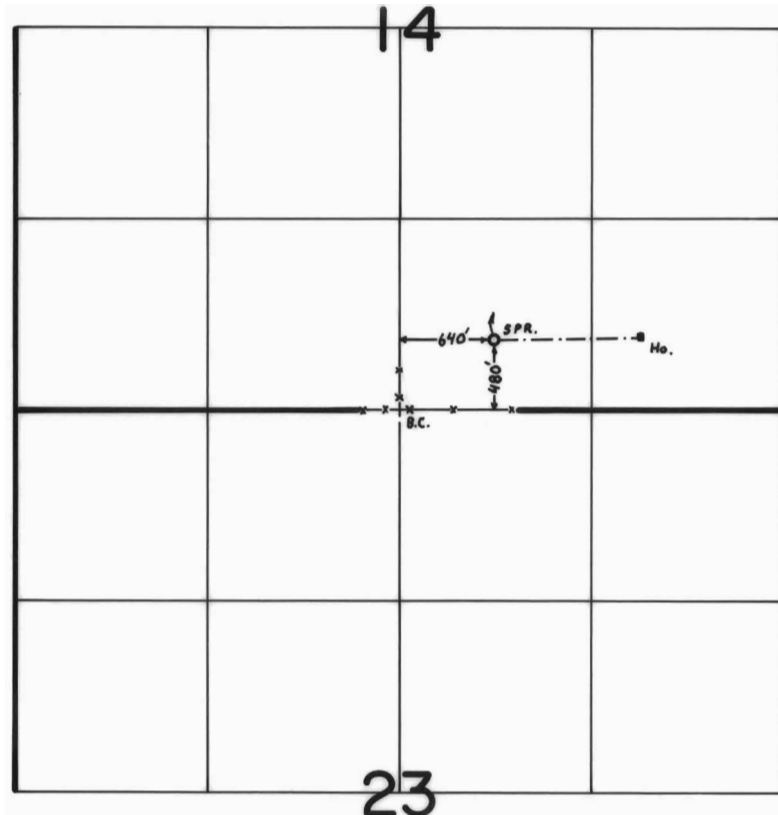

FINAL PROOF SURVEY
UNDER

Application No. 58514 Permit No. 44032.....
IN NAME OF

JOSEPH E. FERLAN

Surveyed Oct. 16 1979, by C. L. HUGHES.....