


T. 5 S., R. 1 E., W.M.

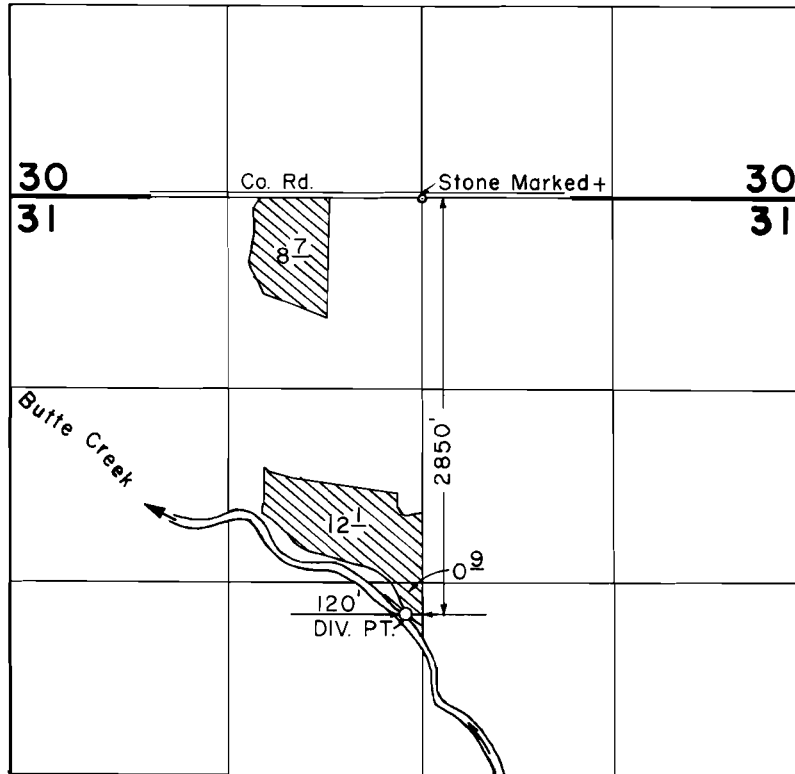

SCALE: 1" = 1320'

FINAL PROOF SURVEY UNDER

Application No. 60132... Permit No. 45031.....
IN NAME OF

HAROLD KRAEMER.....

Surveyed JUNE 13, 1985, by T. WARREN.....