


T. 4 S., R. 2 E., W.M.

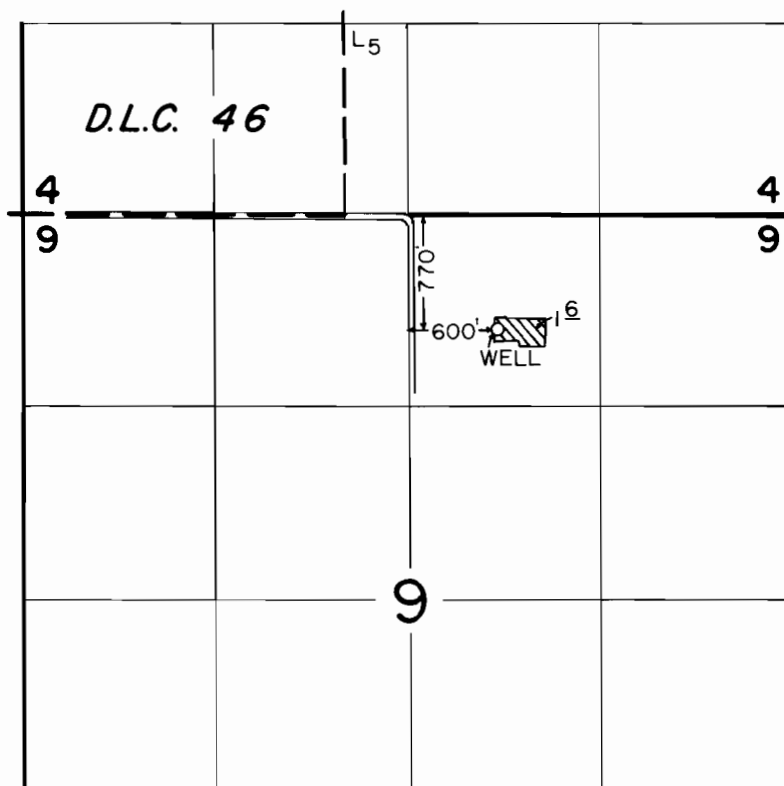

SCALE: 1" = 1320'

FINAL PROOF SURVEY

UNDER

Application No. G-7011... Permit No. G-6511.....
IN NAME OF

.....WALTER E. SCHOENBORN.....

Surveyed JULY 17, 1985, by T. WARREN.....