




T. 5 S., R. 1 E., W.M.

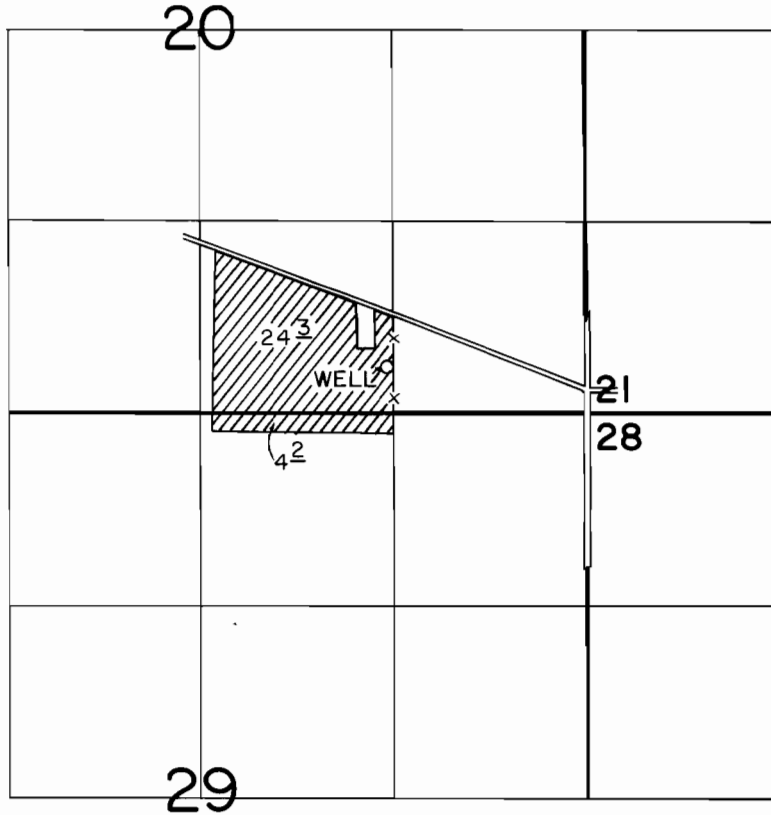

WELL LOC: 310' N. & 1360' W. FROM THE S.E. CORNER SEC. 20

SCALE: 1" = 1320'

FINAL PROOF SURVEY
UNDER

Application No. G-7378. Permit No. G-6978...
IN NAME OF

ARTEMY & MEFODY EFIMOFF

Surveyed JUNE 21, 1985, by T. WARREN