




T. 5 S., R. 1 W., W.M.

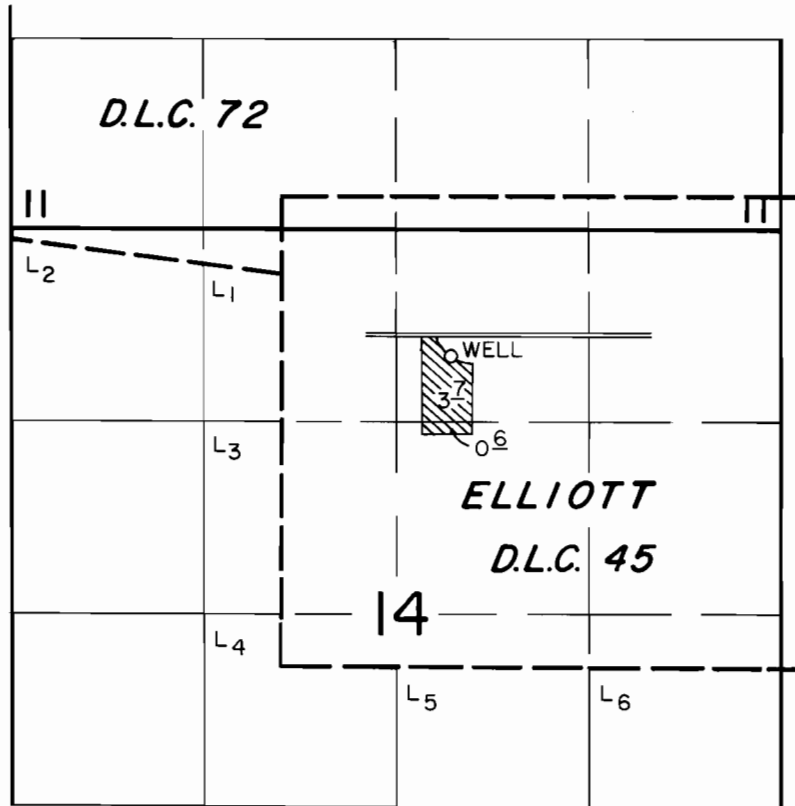

WELL LOC.: 870' S. & 2270' W. FROM THE N.E. CORNER SEC. 14

SCALE: 1" = 1320'

FINAL PROOF SURVEY
UNDER

Application No. G-8614 Permit No. G-7893
IN NAME OF

EPLANTY SNEGIREV

Surveyed JUNE 27, 1985, by T. WARREN