




T. 5 S., R. 1 E., W.M.

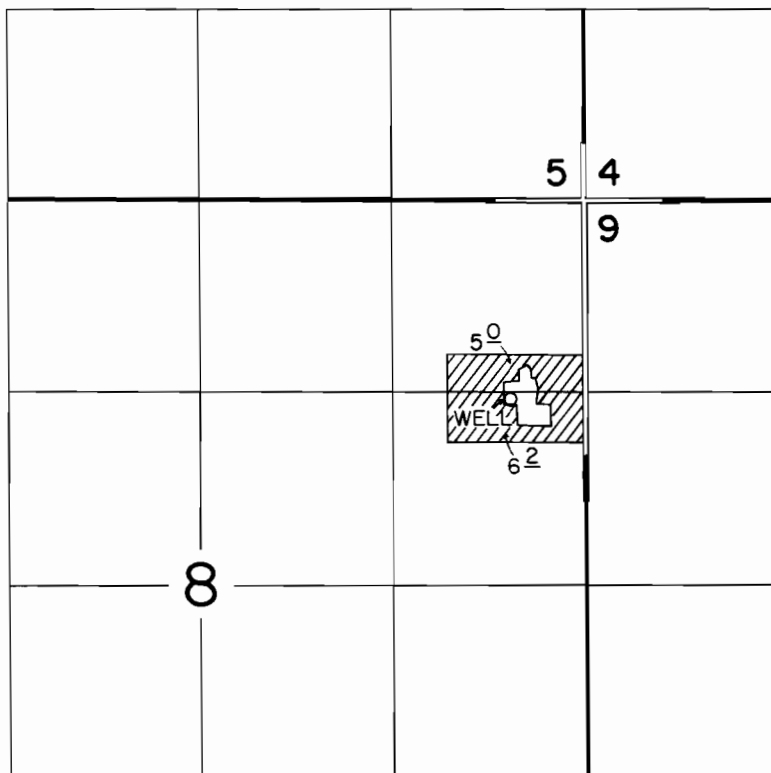

WELL LOC: 1380' S. & 500' W. FROM THE N.E. CORNER SEC. 8

SCALE: 1" = 1320'

FINAL PROOF SURVEY UNDER

Application No. G-9473 Permit No. G-8891....
IN NAME OF

.....CARL F. THOMAS.....

Surveyed JUNE 24, 1985, by T. WARREN.....