


T. 3S., R. 4E., W.M.

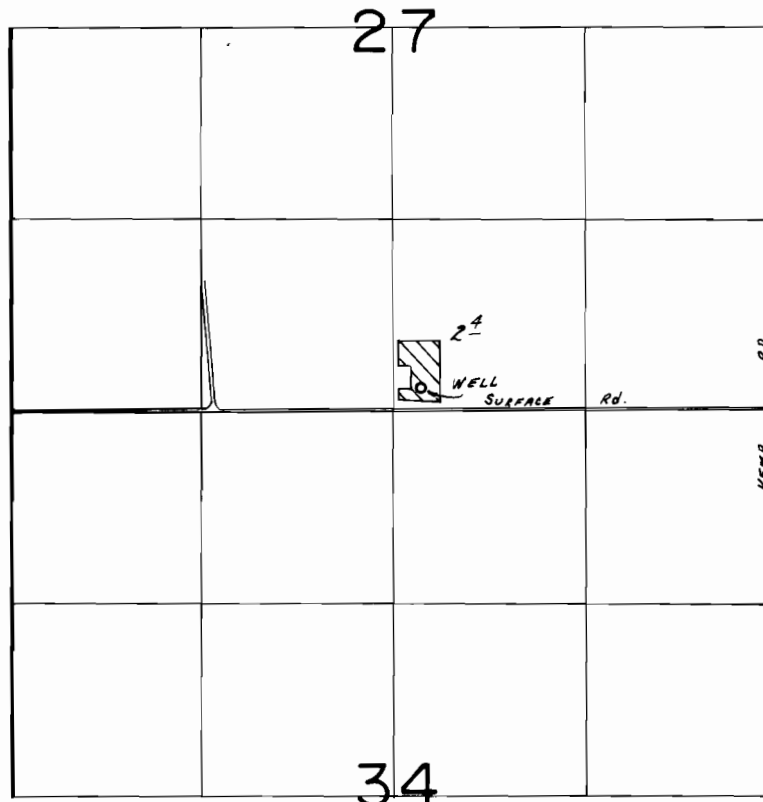

WELL LOC: 150' N. & 190' E. FROM S  $\frac{1}{4}$  COR. SEC. 27

SCALE: 1" = 1320'

## FINAL PROOF SURVEY UNDER

Application No. G-10314. Permit No. G-9441.....  
IN NAME OF

.....BART VANVEEN.....

Surveyed AUG. 7..... 19.84, by B.W. BISHOP.....