


T.4&5S.,R.1E.,W.M.

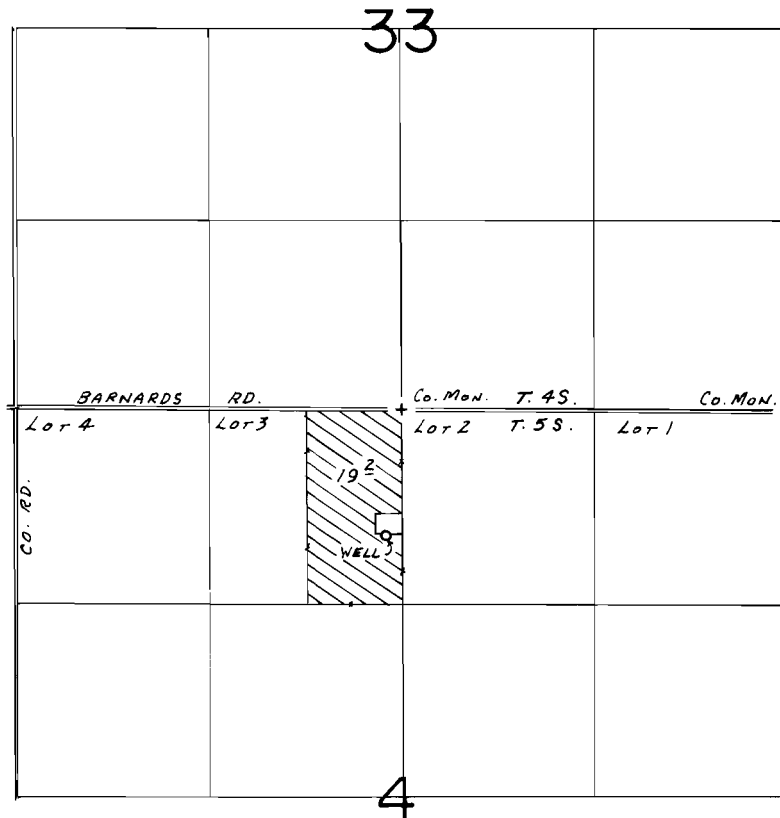

WELL LOC: 860'S. & 100'W. FROM N. 1/4 COR. SEC. 4

SCALE: 1"=1320'

FINAL PROOF SURVEY UNDER

Application No. G-10887. Permit No. G-10030....
IN NAME OF

.....WILLIAM SCHWABAUER.....

Surveyed Aug. 8..... 1984, by J.R. WOODROOF.