




T. 41 S., R. 13 W., W.M.

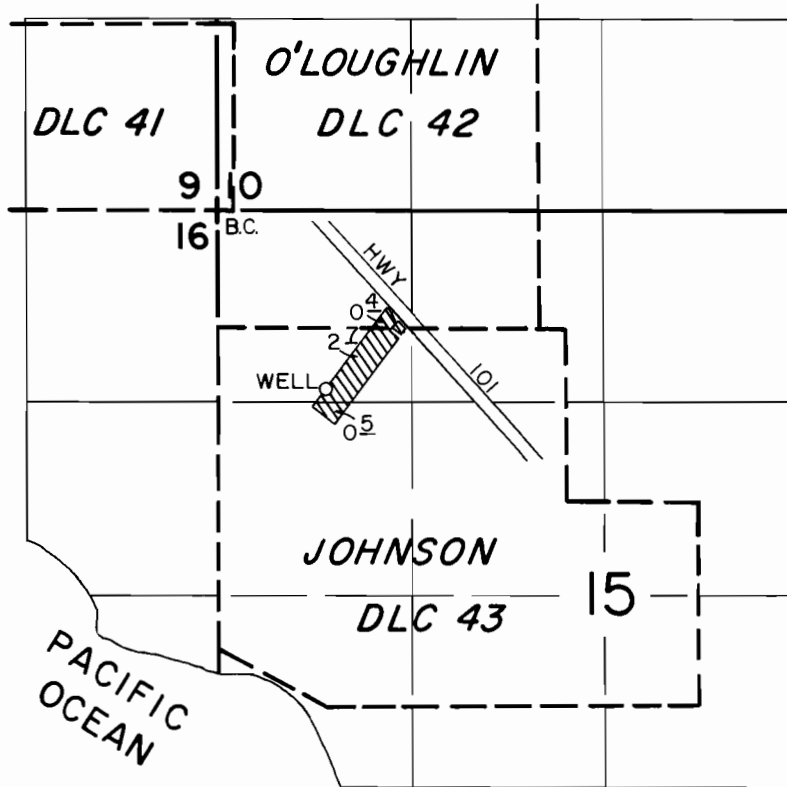

WELL LOC.: 1250' S. & 750' E. FROM THE N.W. CORNER OF SEC. 15

SCALE: 1" = 1320'

FINAL PROOF SURVEY
UNDER

Application No. G-7270. Permit No. G-7083....
IN NAME OF

.....WALTER I. SAYLOR.....

Surveyed APRIL 4, 1985, by L. CASHION.....

