




T. 41 S., R. 13 W., W.M.

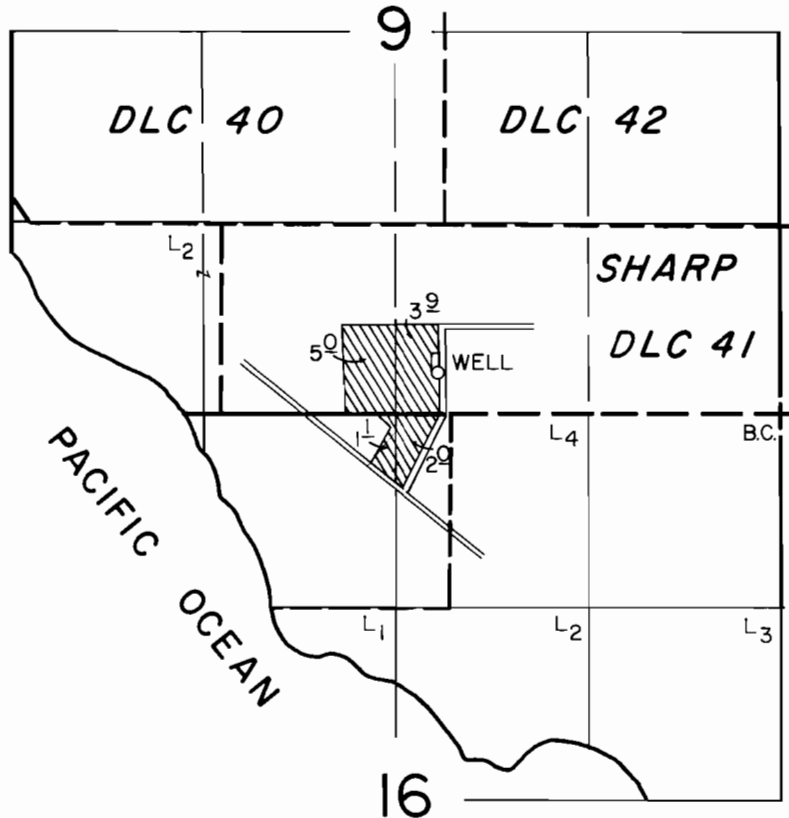

WELL LOC: 280' N. & 2350' W. FROM THE S.E. CORNER OF SEC. 9

SCALE: 1" = 1320'

**FINAL PROOF SURVEY**  
UNDER

Application No. G-9833. Permit No. G-10220.  
IN NAME OF

..... ROBERT R. SWAN .....

Surveyed APRIL 12, 1985, by B.S. JAMES .....