


T.35S., R.4W., W.M.

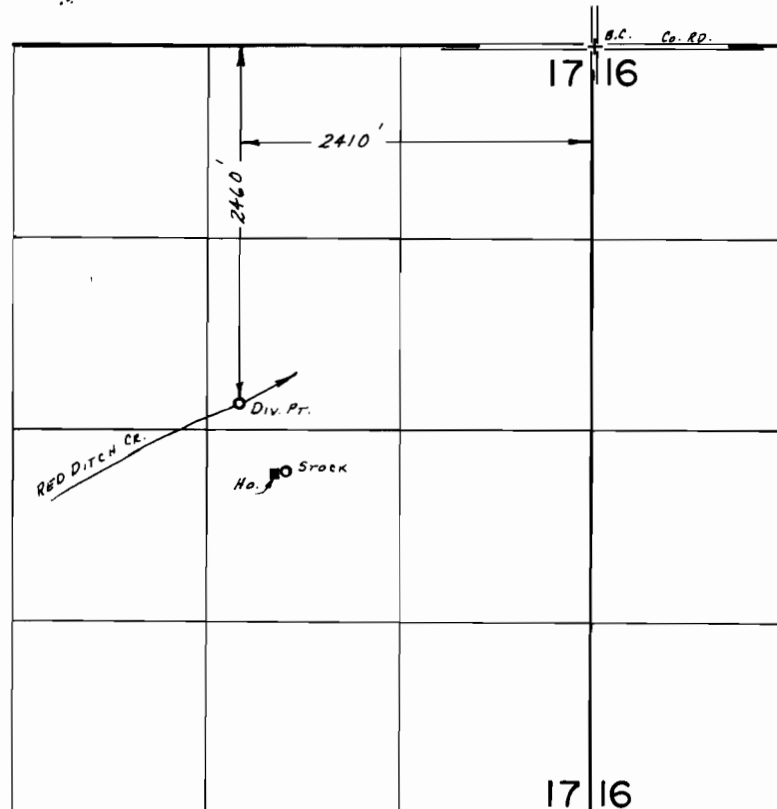

SCALE: 1" = 1320'

# **FINAL PROOF SURVEY** UNDER

Application No. 55198... Permit No. 41407.....  
IN NAME OF

.....RANDALL ALAN FISKE.....

Surveyed Aug. 15... 1985, by J.M. SCHMORDE.