


T. 35S., R. 4W., W.M.

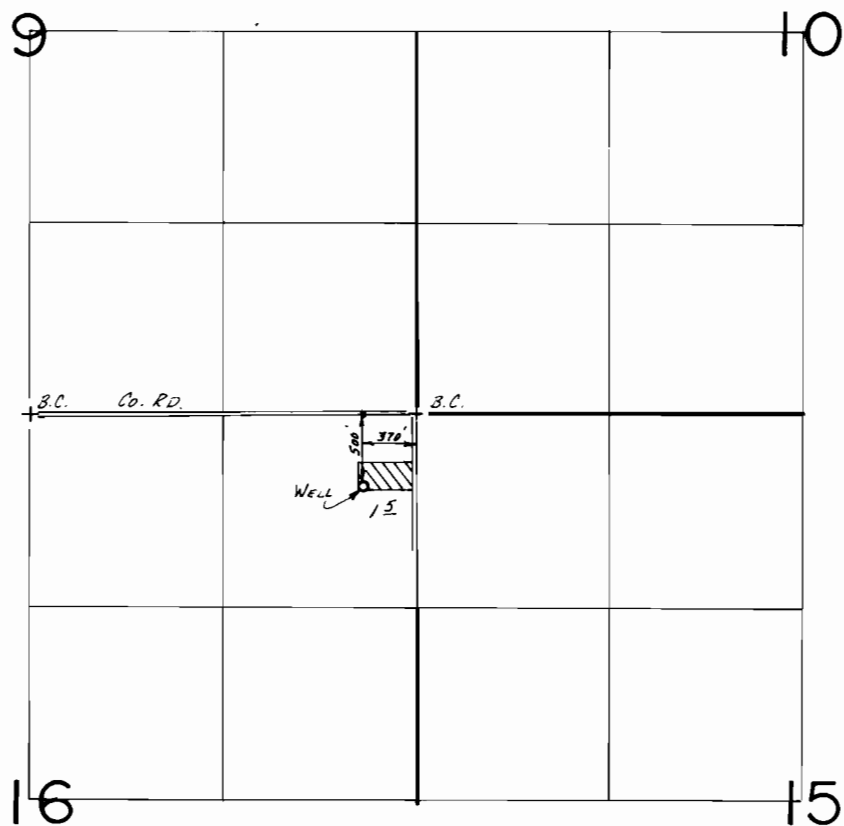

SCALE: 1"=1320'

FINAL PROOF SURVEY
UNDER

Application No. ~~G-10684~~ Permit No. ~~G-9766~~....
IN NAME OF

WILLIAM H. & ESTELLE E. PHILLIPS, III

Surveyed Aug. 13... 19.85., by J. M. SCHMORDE.