



T.27S.,R.16E.,W.M.

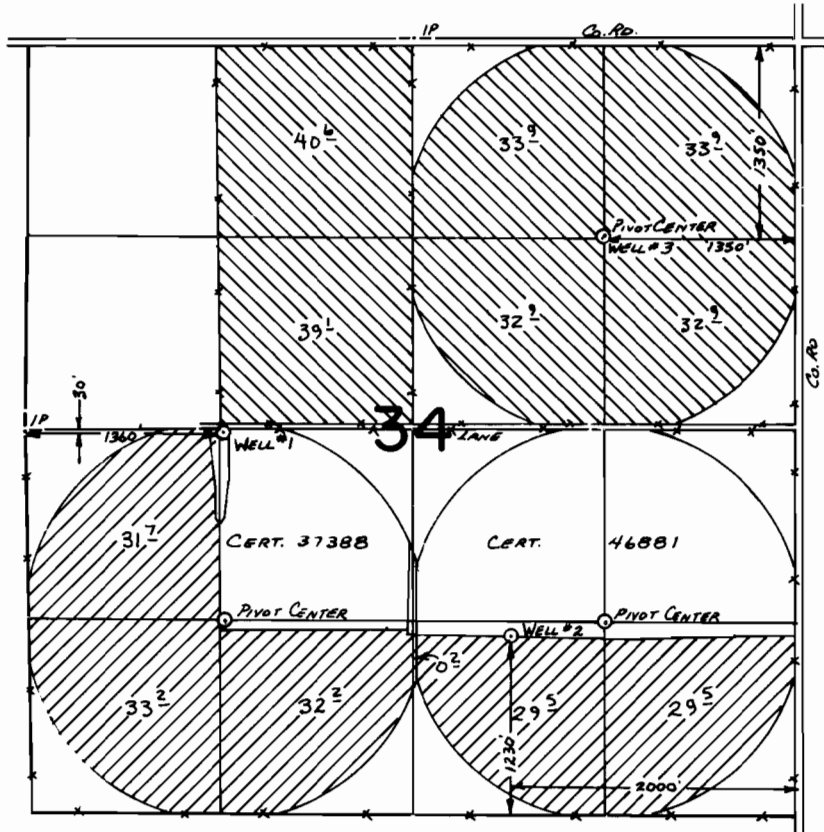

FINAL PROOF SURVEY UNDER

Application No. G-7712 G-8813 Permit No. G-7364 G-8201 
IN NAME OF

MEARL W. & PATTY L. BLEVINS

Surveyed Oct. 14, 1983, by L. M. TOLL