


G-8195
G-8248
54691

T.27S.,R.17E.,W.M.

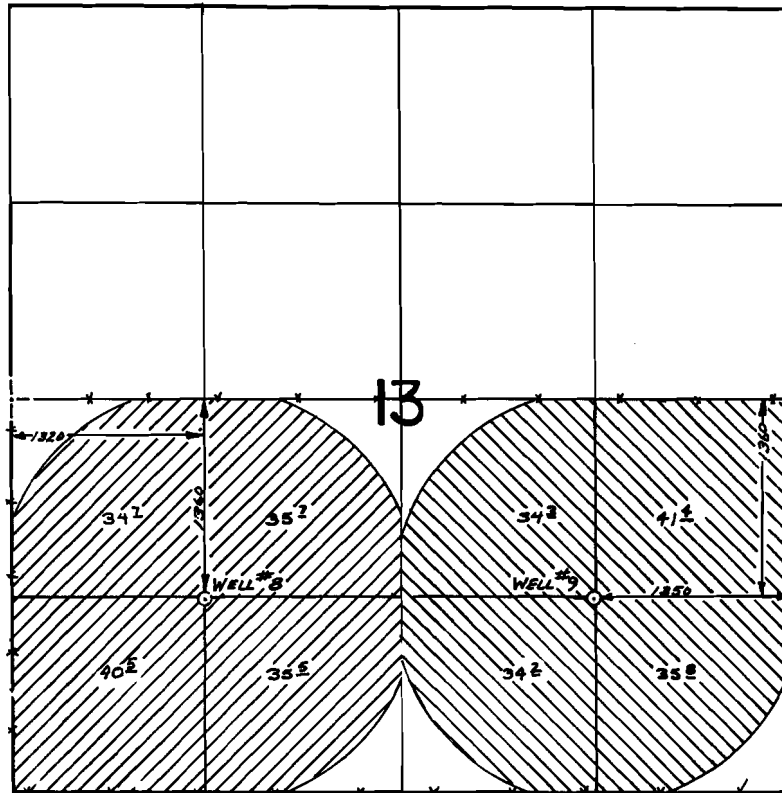

FINAL PROOF SURVEY
UNDER

Application No. G-8746 G-8248
G-8747 Permit No. G-8195
IN NAME OF

DEPARTMENT OF VETERANS' AFFAIRS

Surveyed OCT. 27, 1981, by L. TOLL