


G-8195, 4

G-8248

54692

T.27S.,R.17E.,W.M.

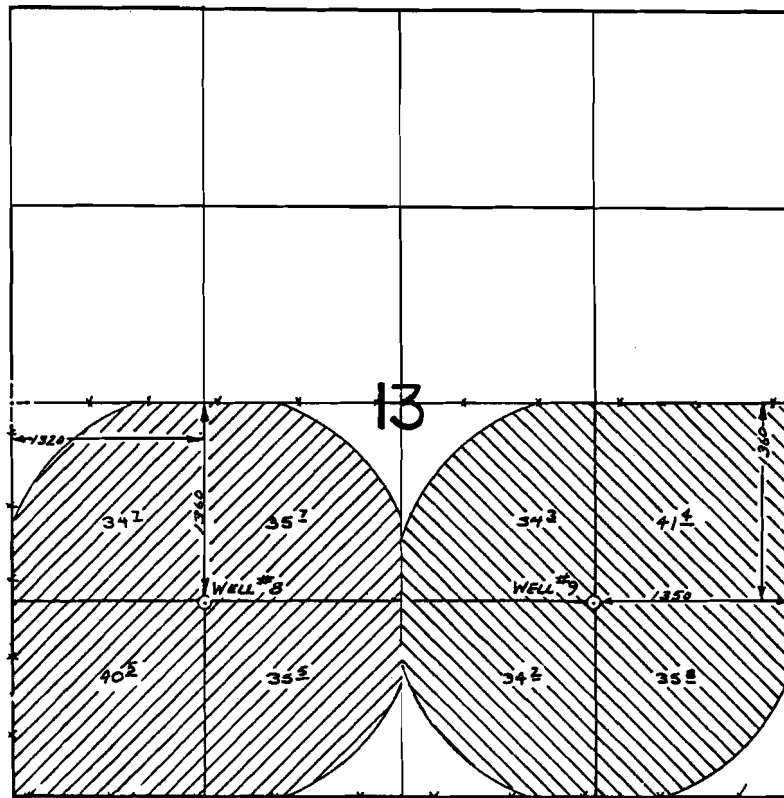

FINAL PROOF SURVEY

UNDER

Application No. G-8746 G-8248
 G-8747 Permit No. G-8195
 IN NAME OF



DEPARTMENT OF VETERANS' AFFAIRS

Surveyed OCT. 27, 1981, by J.L. TOLL