


G-9078  
54693  
T7978

T. 27S., R. 17 E., W. M.

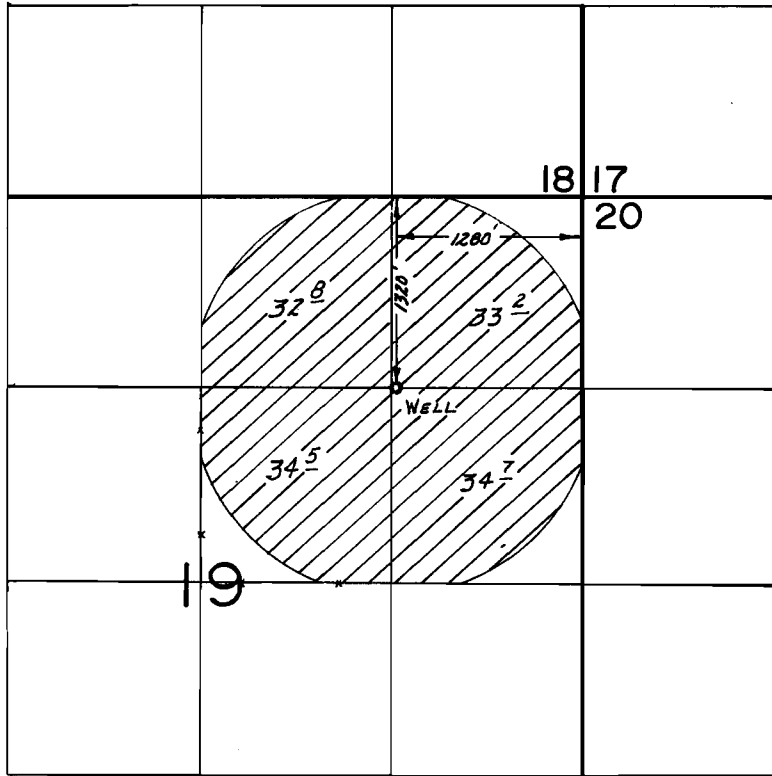

SCALE: 1" = 1320'

**FINAL PROOF SURVEY**  
UNDER

Application No. G-10036 Permit No. G-9078.....  
IN NAME OF

DEPARTMENT OF VETERANS' AFFAIRS

Surveyed Sept. 16... 19.85, by B.W. BISHOP.....

PTS 1985L *BWB*