


G-8375
54694

T.27S.,R.17E.,W.M.

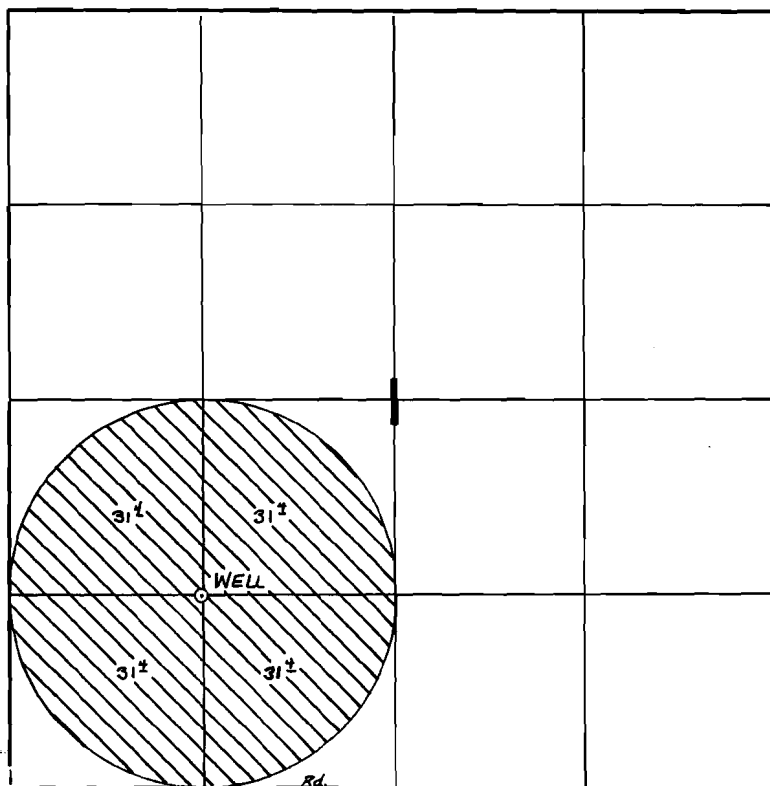

WELL Loc: 1320 ft N. and 1320 ft E. from the SW Cor. Sec. 1

FINAL PROOF SURVEY
UNDER

Application No. G-9024 Permit No. G-8375.....
IN NAME OF

GERALD D. & SYLVIA HALL

Surveyed OCT. 23 1981, by L. TOLL.....