


G-8820
54695

T.26S.,R.18E.,W.M.

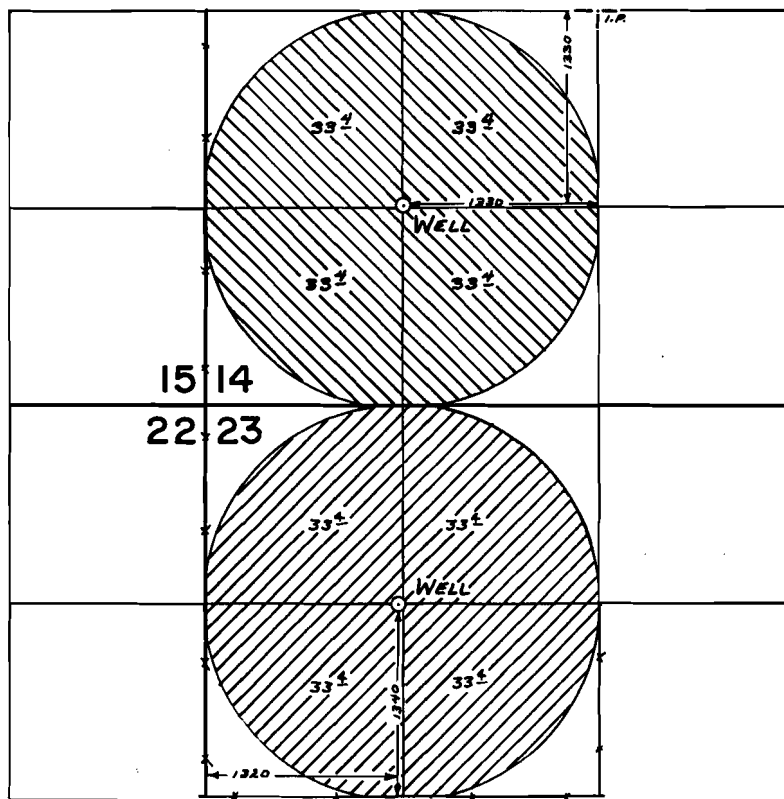

FINAL PROOF SURVEY
UNDER

Application No. G-9622 Permit No. G-8820

IN NAME OF

DONALD R. AND
MARLENE A. BOYLES

Surveyed OCT 26 1981, by L. TOLL