


T.25S., R.19E., W.M.

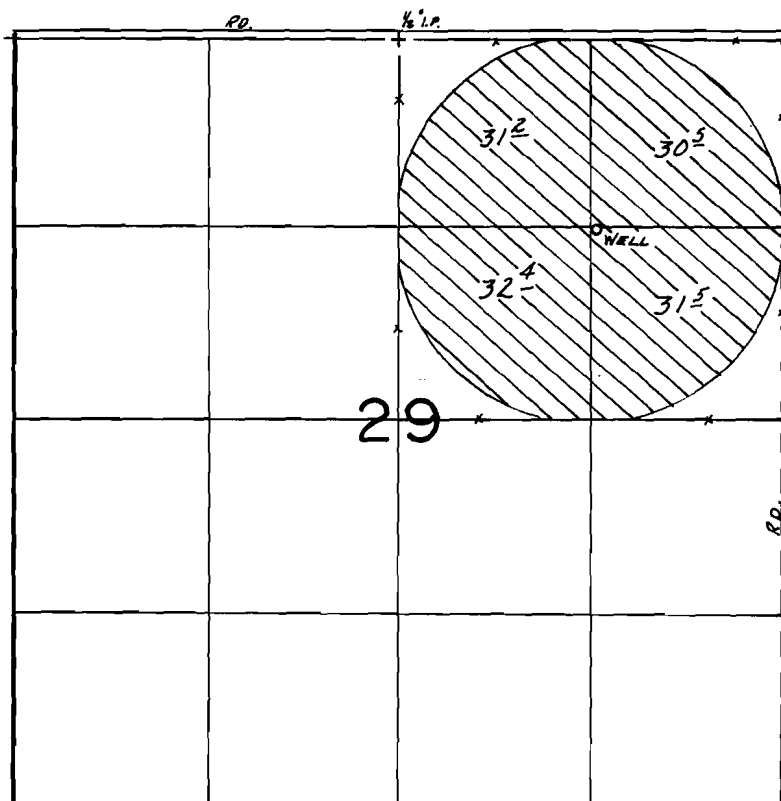

WELL LOC.: 1340 S. & 1280 W. FROM NE COR. SEC. 29.

SCALE: 1"=1320'

FINAL PROOF SURVEY UNDER

Application No. G-10247 Permit No. G-9279....
IN NAME OF

.....CECIL R. ALBERTS.....

Surveyed Sept. 18... 1985, by B.W. BISHOP.....