


T. 25 S., R. 18 E., W. M.

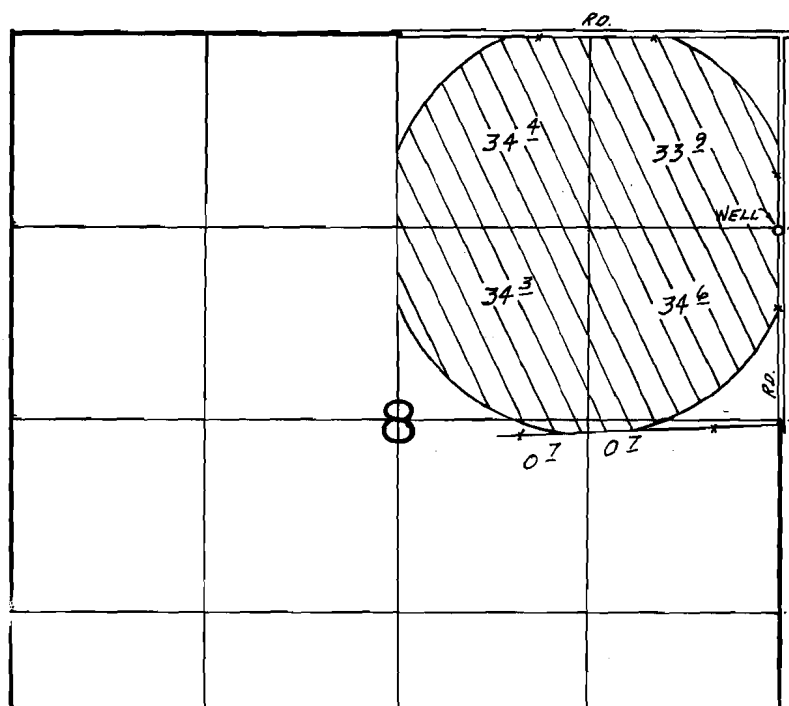

WELL LOC.: 1340'S. 20' W. FROM NE COR. SEC. 8.

SCALE: 1"=1320'

FINAL PROOF SURVEY UNDER

Application No. G-11167... Permit No. G-10329...
IN NAME OF

JAMES B. DINSDALE

Surveyed Oct. 10, 1985, by B.W. BISHOP