


RECEIVED

FEB 23 1978

WATER RESOURCES DEPT.
SALEM, OREGON

T.16S. R.5E. W.M

Application No. *56499* SEC. 14
Permit No. *42765*

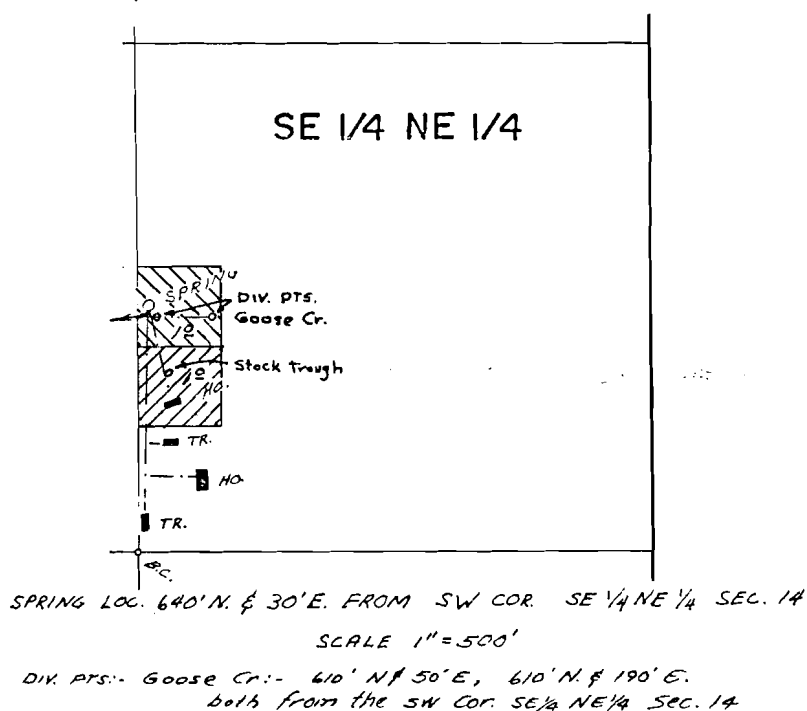

 from creek w/def. from Spring
 from spring w/def. from Creek

FINAL PROOF SURVEY
UNDER

Application No. *37988* Permit No. *28324*...
IN NAME OF

.....WALTER A. SACKS.....

Surveyed AUG. 30. 1977, by L.H. NUNN.....