


T. 16 S., R. 5 W., W.M.

GIBSON DLC 43

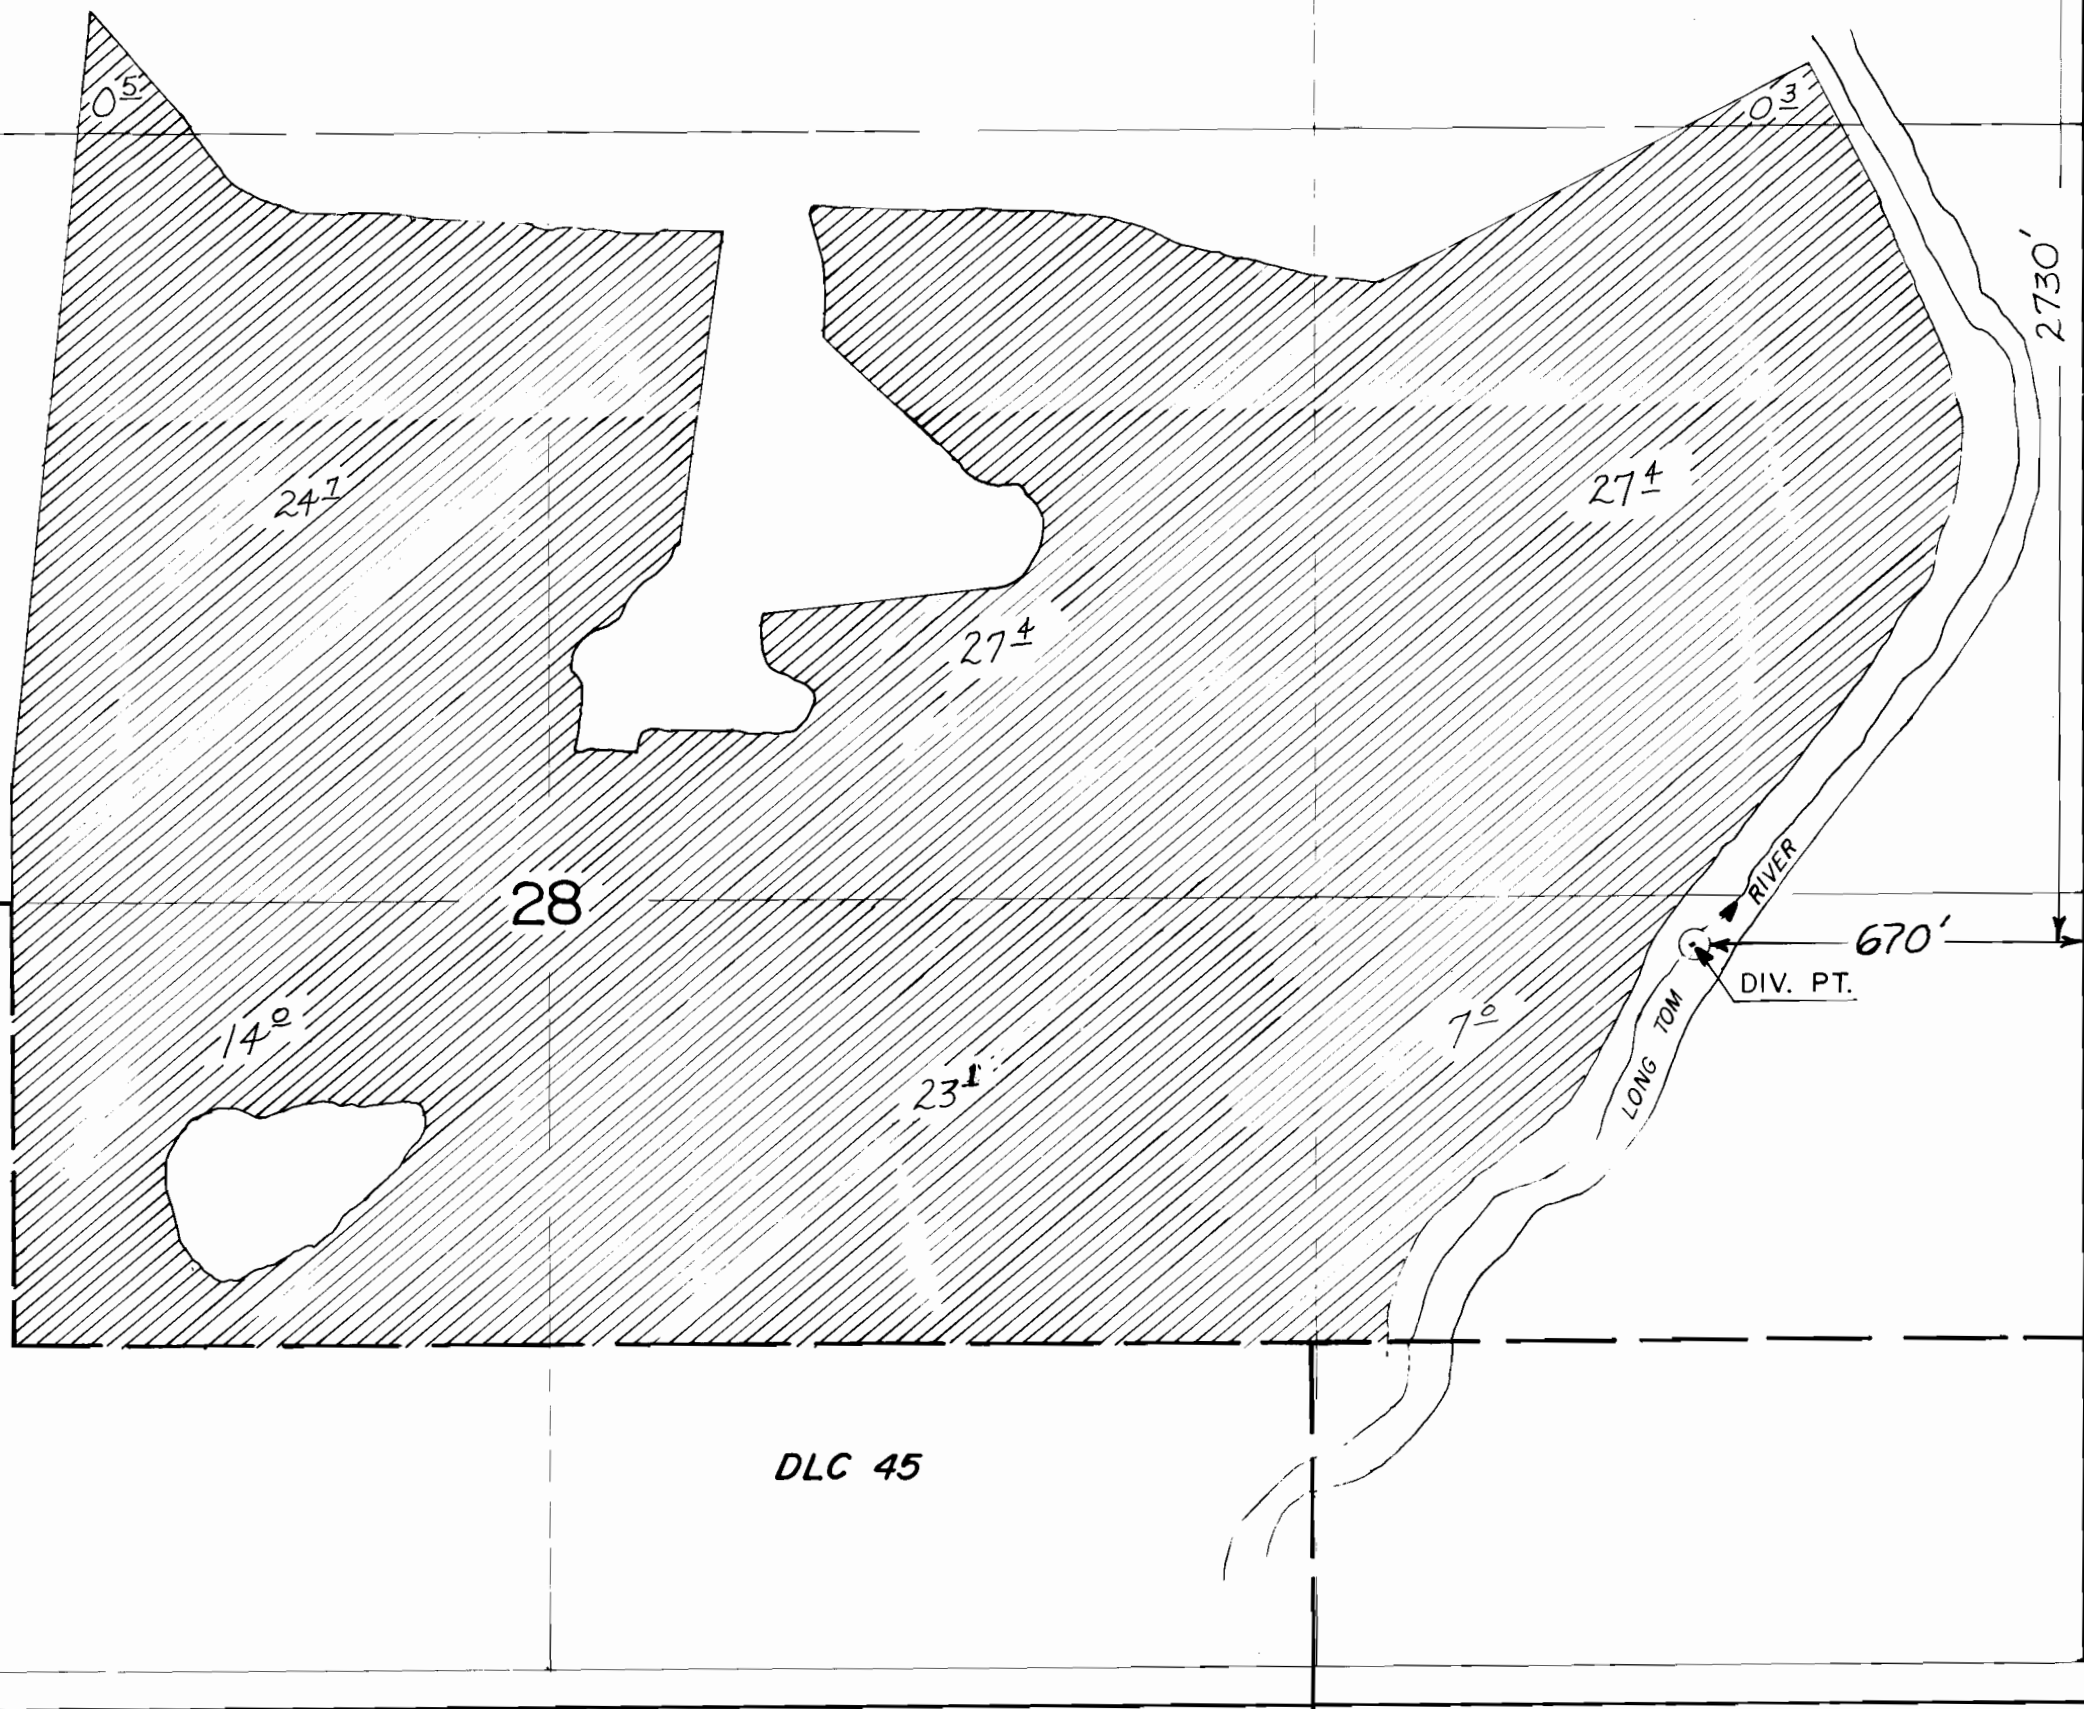

SCALE: 1" = 330'

FINAL PROOF SURVEY
UNDER

Application No. 58544, Permit No. 45282...
IN NAME OF

GOSHEN HOLE FARM c/o PATRICIA S. ALEXANDER

Surveyed SEPT. 26 1985, by B.W. BISHOP

ASCS PHOTO
ZOOM M.C.