
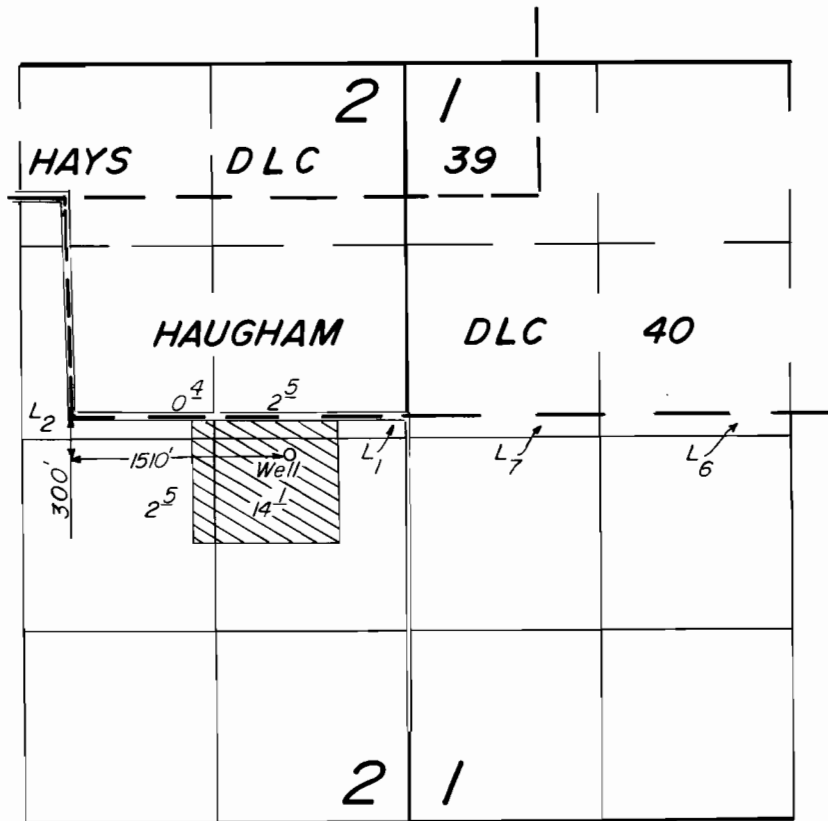


T. 17S., R. 5W., W.M.

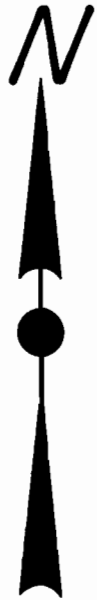

Scale : 1" = 1320'

FINAL PROOF SURVEY
UNDER

Application No. *G-10124*.. Permit No. *G-9519*.....

IN NAME OF

HARLEY E. CASE

Surveyed *May 20* 19*85*., by *T. Warren*.....